

Pearl River  
 N20  
 5-16-81

MISSISSIPPI  
 BOARD OF WATER COMMISSIONERS  
 416 North State Street  
 Jackson, Mississippi 39201

**CODED**

WATER WELL DRILLERS LOG

BRADEN PUMP AND WELL SERVICE, INC. Pearl River

S-110  
 date well completed

1981  
 ROUTE 1, BOX 489  
 SAUCIER, MS 39574

county well located

LANDOWNER:  
 HARRY LADNER  
 Rt 2, Box 125  
 Poplarville, MS 39470  
 (mailing address)

description of formations encountered	from	to
Sand	0	10
CLAY	10	20
SAND	20	35
CLAY	35	60
Sand	60	70
CLAY	70	165
SAND	165	175
CLAY	175	180
SAND	180	200

WELL LOCATION:

sec. 31 T. 3 N. R. 14 E.  
 S W  
 8 miles SE of Poplarville  
 (distance) (direction) (nearest town)

WELL PURPOSE: home  
 (home, irrigation, municipal, industrial)

WELL COMPLETION DATA:


- (1) diameter (inches) 4"
- (2) total depth (feet) 200'
- (3) static water level (feet) 125 below above top of ground.
- (4) casing PVC, total 4" (material) (depth) (size) If telescope see back.
- (5) screen 10' 185 (length) (depth to top) 5" PVC underbar (size) (material)
- (6) pump 1 1/2 30 (HP) (yield gpm) 230 (type power)
- (7) electric log no (yes or no)

(organization running log)

(8) how well bottom plugged 2" sand shark

DRILLERS REMARKS: 51 tail pipe

**CODED**

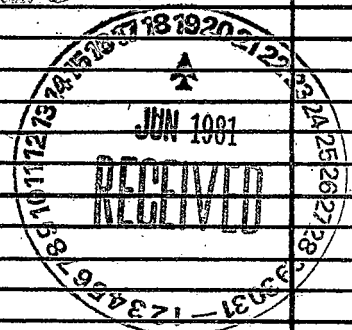

If well telescopes please sketch and show depths.

GROUND LEVEL

X			

SECTION 31

Please indicate well location X.

ADDITIONAL INFORMATION

If more than one screen, show locations of each on sketch.