

PEARL RIVER
 N21
 6-3-82

MISSISSIPPI DEPARTMENT OF NATURAL RESOURCES
 Bureau of Land and Water Resources
 Southport Mall
 P.O. Box 10631
 Jackson, Mississippi 39209
 WATER WELL DRILLERS LOG

6-3 1982 date well completed
 Pearl River county well located

LANDOWNER: Mr. Barber

description of formations encountered

Camp. A. So. So.

Top - 0 8

(mailing address)

Sd To Big Mound - 8 40

WELL LOCATION:

sec. 23 T. 3 N R. 14 E
3 miles NNW of Silverton
 (distance) (direction) (nearest town)

Clay some hd int. 40 364
 St. James silt.

WELL PURPOSE: Camp
 (home, irrigation, municipal, industrial)

Sd. Pine 364 381

WELL COMPLETION DATA:

- (1) diameter (inches) 2
- (2) total depth (feet) 532
- (3) static water level (feet) 18 below above top of ground
- (4) casing PVC, 512
 (material) (depth)
2 if telescope see back.
 (size)
- (5) screen 20, 512
 (length) (depth to top)
2, PVC
 (size) (material)
- (6) pump 3/4, 12
 (HP) (yield gpm)
AC 220
 (type power)
- (7) electric log
 (yes or no)
 (organization running log)
- (8) how well bottom plugged solid

Clay hd. 381 408

S. Pine int. silt. 408 506

good sd - 506 532

DEPT. OF NATURAL RESOURCES
 BUREAU OF LAND & WATER RESOURCES


AUG - 6 1982

RECEIVED

DRILLERS REMARKS:

If well telescopes please sketch and show depths.

GROUND LEVEL

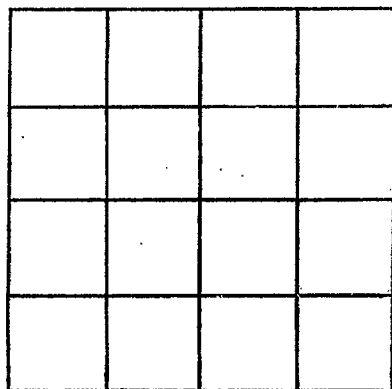

SECTION _____

Please indicate well location X.

ADDITIONAL INFORMATION

If more than one screen, show locations of each on sketch.