	State W	ell Report		
County: Coarl River		•	For Office Use Only:	
County:	Part 1 Mississippi Department of Environmental Quality		Aquifer:	
Permit #:	Office of Land and Water Resources			
Driller: AL HARRINGTON	P.O. Box 10631		Well #: <u>N- 41</u>	
	Jackson, MS 39289-0631		L. S. Elevation: 236	
Date drilling completed: <u>5/10/05</u>		961-5210		
	(601)354-6938 (fax)		E-log #:	
State Law requires that this report be prepared by the driller in detail and filed with the Department within 30 days of completion of drilling of the well.				
	ation ALOMBRO?		Location	
Owner Name Denise alambra		Latitude: <u>30° • 44 · 47.9</u> " Longitude: <u>26</u> ,00.9"		
Mailing Address: Emill Davis Rd M		Method of Lat/Long (circle one): Conventional Survey,		
USGS quad, (Hand-hel		GPS, Survey-grade GPS		
Paplarinelle Mrg 39470		NE 14 SW 14 Sec 31 Twn 35 Rng 14W		
City State Zip Code				
Telephone No. ()		Distance Direction	of Paplamille	
Well Data				
Well Data				
Purpose of Well (circle one Home Industrial Public Supply Irrigation Fish Culture Other:				
Date well drilling started: <u>5/9/05</u> Date well drilling completed: <u>5/10/05</u>				
If flowing, method of flow regulation: Valve Other (describe)				
Static Water Level: 129 feet above or below (circle one) land surface Date measured: 5/10/05				
Method of Measurement (circle one) steel tape electric tape air line other:				
Hole depth: 238' Well depth: 238' Well grouted to a depth of 10' feet				
Type of grout (circle one): Cement Bentonite Mix				
Casing length: $\frac{15814}{15814}$ feet Casing diameter: $\frac{1422}{1422}$ inches Type of casing: $\frac{PUC}{142}$				
Screen length: <u>10</u> feet Screen diameter: <u>2</u> inches Type of screen: <u>PVC Nawed</u>				
Screen slot size: <u>1008</u> inches Setting depth: From <u>228</u> feet to <u>238</u> feet				
Type of completion (circle all applicable): Gravel packed Underreamed Telescoped Open hole Natural Development				
$\frac{\text{Other} (\text{describe}):}{44 \times 2} = \frac{1}{2} + \frac{1}{2}$				
Top of lap pipe or reduction in casing:feet. If telescoped or more than one screen, describe on back of page				
Other (describe):				
Name of organization running log(s):				
I certify that the well was drilled, constructed, and completed in accordance with all applicable requirements of the Mississippi				
Department of Environmental Quality and/or the Mississippi Department of Health regulations and state laws.				
AL HARRINGTON #0-564 al Mainington				

Print Name of Water Well Contractor and License No.


,

×

Signature of Water Well Contractor

Success

2. 2. **C** If well telescopes please sketch below and show depths.

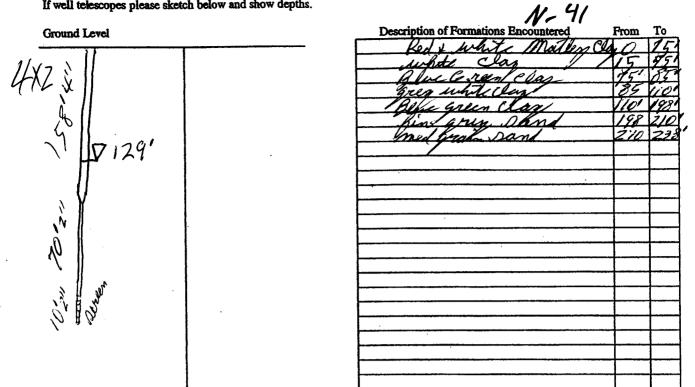

If more than one screen, show location of each on sketch

Sketch the property layout and include the following: 1) the well location; 2) any permanent structures on the property that may aid in locating the well; 3) any roads, power lines, or other items that may aid in locating the property and the well; 4) indicate direction. WELL BARN 0 17114 DWELLWG DRIVE enise alambro Landowner Name:

Signature of Water Well Contracto

n an taga an

STATE WELL REPORT				
Permit #: Mississippi Dep Office of Driller: <u>AL HARRINGTON</u> Jac Date completed: <u>5/10/05</u>	Part 2 staller's Completion Report partment of Environmental Quality f Land and Water Resources P.O. Box 10631 kson, MS 39289-0631 (601)961-5210 (601)354-6938 (fax)			
This report should be prepared by the pump installer in detail and filed with the Department within 30 days of the installation of pump.				
Well Owner Information Owner Name: <u>Denise Allombro</u> Mailing Address: <u>5 Emill Paris Rd</u> <u>Paplewinlle MG 39477</u> Gty State Zip Code Telephone No. (Well Location Latitude: <u>N30° 444 43.9</u> Longitude: <u>89°.26° 00.9</u> " Method of Lat/Long (circle one): Conventional Survey, USGS quad. (Hand-held GP\$) Survey-grade GPS NE 14 Sec. <u>31</u> Twn. <u>35</u> Rng. 14W Distance Direction Nearest Town 10 Miles <u>5E</u> of <u>Papelarwille</u>			
Pump Type Power Type				
Circle one	Power Type Circle one			
Air Lift Jet Submersible	Diesel Engine Gasoline Engine Natural Gas			
Bucket Piston Turbine	Electric Motor Hand Tractor PTO			
Centrifugal Rotary Flowing Well	Windmill Other (specify):			
Other (specify):	Horse Power Rating of Motor: 1HP			
Date Pump Installed: 5/10/05	Setting Depth:feet			
Rated Pump Capacity: Gallons Per Minu	nte Number of Stages: <u>12 GPM Derive</u> HP			
Pump Test Data	Method of Measuring Water Level			
Date Well Tested:5/10/05	Circle one			
Static Water Level (A): <u>129</u> Feet Below Land Surfa				
Pumping Water Level (B): <u>7150</u> Feet Below Land Surface	Ce Other (specify):			
Drawdown [(B) - (A)]:Feet Below Land Surfa	For flowing well, measured shut in head:feet			
Test Pumping Rate:Gallons Per Minu	Well yieldedGPM with a drawdown of			
Duration of Pump Test (minimum 4 hours):hou	rsfeet afterhours of pumping			
I HEREBY CERTIFY that the above statements are true to the best of my knowledge.				
AL HARRINGTON # 0-564 /// Marrington				

Print Name of Pump Installer and License No. (if applicable)

•

.

Signature of Pump Installer

.

there are in the second

1. 2. 5. 8.