

Pearl River
N 2001
3-14-77

MISSISSIPPI
 BOARD OF WATER COMMISSIONERS
 416 North State Street
 138 Jackson, Mississippi 39201

WATER WELL DRILLERS LOG

3-14 1977 Remell Anderson Pearl River
 date well completed firm name county well located


LANDOWNER:	description of formations encountered	from	to
<u>Jim DeBolin</u> (mailing address)	<u>Top Soil</u>	<u>0</u>	<u>3</u>
	<u>R. of Clay</u>	<u>3</u>	<u>18</u>
	<u>Fine Sand</u>	<u>18</u>	<u>58</u>
	<u>Course Sand</u>	<u>58</u>	<u>71</u>
WELL LOCATION: sec. <u>2</u> T. <u>3</u> N. R. <u>14</u> E. S. <u>W</u> <u>10</u> miles <u>E</u> of <u>Poplarville</u> (distance) (direction) (nearest town)			
WELL PURPOSE: <u>HOME</u> (home, irrigation, municipal, industrial)			
WELL COMPLETION DATA: (1) diameter (inches) <u>2"</u> (2) total depth (feet) <u>71'</u> (3) static water level (feet) <u>41'</u> below above top of ground. (4) casing <u>Plastic 66'</u> (material) (depth) ____ (size) if telescope see back. (5) screen <u>5'</u> <u>66'</u> (length) (depth to top) <u>2"</u> <u>Plastic</u> (size) (material) (6) pump <u>1/2</u> <u>3'</u> (HP) (yield gpm) <u>Elect</u> (type power) (7) electric log <u>no</u> (yes or no) ____ (organization running log) (8) how well bottom plugged <u>Capped</u>			
DRILLERS REMARKS:			

RECEIVED
 APR 7 1977

MISS. BD. OF WATER COMMISSIONERS

If well telescopes please sketch and show depths.

GROUND LEVEL

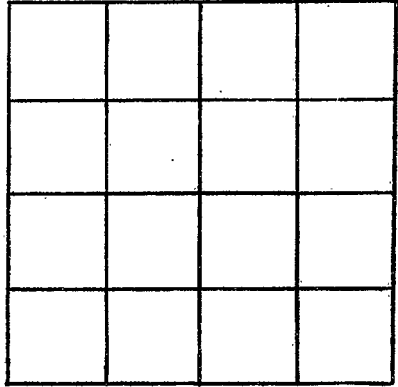

SECTION _____

Please indicate well location X.

ADDITIONAL INFORMATION

If more than one screen, show locations of each on sketch.