

Pearl River
 N 2002
 3-15-77

MISSISSIPPI
 BOARD OF WATER COMMISSIONERS
 416 North State Street
 138 Jackson, Mississippi 39201

WATER WELL DRILLERS LOG

3-15-77 date well completed
 138 Pearl River firm name
 Pearl River county well located


LANDOWNER:	description of formations encountered	from	to
Wayne Roberts (mailing address)	Top Soil Coarse Sand	0	4 70
WELL LOCATION:			
sec. 2 T 3 N R 14 E 10 miles E of Poplarville (distance) (direction) (nearest town)			
WELL PURPOSE: HOME USE (home, irrigation, municipal, industrial)			
WELL COMPLETION DATA:			
(1) diameter (inches) 2"			
(2) total depth (feet) 70'			
(3) static water level (feet) 14' below top of ground			
(4) casing (material) Plastic (depth) 65'			
(size) If telescope see back.			
(5) screen (length) 5' (depth to top) 65'			
(size) 2" (material) Plastic			
(6) pump (HP) 1/2 (yield gpm) 8			
(type power) Elect			
(7) electric log (yes or no) NO			
(organization running log)			
(8) how well bottom plugged Capped			
DRILLERS REMARKS:			

RECEIVED
 APR 7 1977

MISS. BD. OF WATER COMMISSIONERS

If well telescopes please sketch and show depths.

GROUND LEVEL

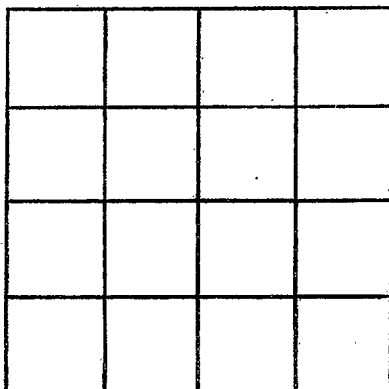

SECTION _____

Please indicate well location X.

ADDITIONAL INFORMATION

If more than one screen, show locations of each on sketch.