

Pearl River
 N 2003
 1/5/78

MISSISSIPPI
 BOARD OF WATER COMMISSIONERS
 416 North State Street
 Jackson, Mississippi 39201

WATER WELL DRILLERS LOG

1-5 1978 Horne & Madson Pearl River
 date well completed firm name county well located

LANDOWNER:
J. C. Seals
 (mailing address)

description of formations encountered	from	to
	ft	ft
Top Soil	0	2
Red Clay	2	28
Fin Sand	28	88
Coars. Sand	88	95

WELL LOCATION:
 sec. 2 T. 3 S. R. 14 W.
12 miles SE of Poplarville
 (distance) (direction) (nearest town)

WELL PURPOSE: HOME
 (home, irrigation, municipal, industrial)

WELL COMPLETION DATA:

(1) diameter (inches) 2"

(2) total depth (feet) 95'

(3) static water level (feet) 38' below above top of ground.

(4) casing Plastic 90'
 (material) (depth)

(size) If telescope see back.

(5) screen 15' 90'
 (length) (depth to top)

2" Plastic
 (size) (material)

(6) pump 1/2 15
 (HP) (yield gpm)

Elect
 (type power)

(7) electric log no
 (yes or no)

(organization running log)

(8) how well bottom plugged capred


DRILLERS REMARKS:

RECEIVED
 507
 FEB 9 1978

MISS. BD. OF WATER COMM

If well telescopes please sketch and show depths.

GROUND LEVEL

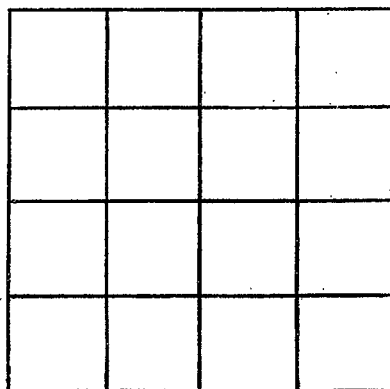

SECTION _____

Please indicate well location X.

ADDITIONAL INFORMATION

If more than one screen, show locations of each on sketch.