

PEAR RIVER  
 N 2004  
 11-30-78

MISSISSIPPI  
 BOARD OF WATER COMMISSIONERS  
 416 North State Street  
 Jackson, Mississippi 39201

WATER WELL DRILLERS LOG

11/30 1978 Bud Thornton Jan Pearl River  
 date well completed firm name county well located

LANDOWNER Emerson Jordan  
 RT. 2 paphroville miss.  
 (mailing address)

description of formations encountered	from	to
Red Shale	0	30
Red Sand	30	60
White Sand	60	109


WELL LOCATION:  
 sec. 6 T-3 N R-14 E  
 S W  
 12 miles East of Paphroville  
 (distance) (direction) (nearest town)

WELL PURPOSE: Home  
 (home, irrigation, municipal, industrial)

- WELL COMPLETION DATA:
- (1) diameter (inches) 4
  - (2) total depth (feet) 109
  - (3) static water level (feet) 33 below above top of ground.
  - (4) casing PVC 100 (material) (depth)  
 30 (size) if telescope see back.
  - (5) screen 4x10 100 (length) (depth to top)  
 12 PVC (size) (material)
  - (6) pump 1/2 850 (HP) (yield gpm)  
 Elect 9PH (type power)
  - (7) electric log no (yes or no)

(organization running log)  
 (8) how well bottom plugged  
 Sand Shale

DRILLERS REMARKS:

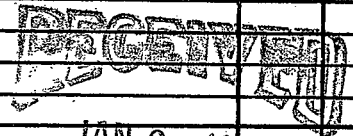


JAN 26 1978

MISS. BD. OF WATER COM.

If well telescopes please  
sketch and show depths.

GROUND LEVEL

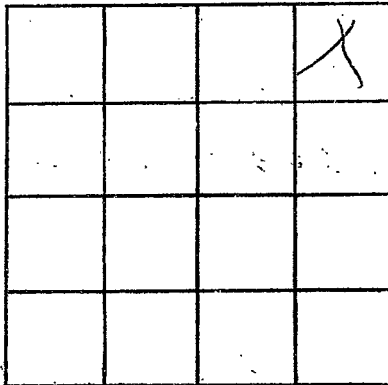

SECTION \_\_\_\_\_

Please indicate well location X.

ADDITIONAL INFORMATION

If more than one screen,  
show locations of each on sketch.