

MISSISSIPPI DEPARTMENT OF NATURAL RESOURCES

Bureau of Land and Water Resources

Southport Mall

P.O. Box 10631

Jackson, Mississippi 39209

WATER WELL DRILLERS LOG

BUD PENTON & SON
WATER WELL SERVICE
ROUTE 3 BOX 41
CARRIERS, MS 39426
PHONE 798-5324

Richard Riven
county well located

Pearl River
N 2000
7-13-81

7-13 1981
date well completed

LANDOWNER: Ed Hall
Silver Run Mrs.

description of formations encountered	from	to
	<u>Gray Shale</u>	<u>0</u>
<u>White Sand</u>	<u>20</u>	<u>391</u>

(mailing address)

WELL LOCATION:

sec 35 T 3 N R 14E
12 miles SE of Topshamville
(distance) (direction) (nearest town)

WELL PURPOSE: Home
(home, irrigation, municipal, industrial)

WELL COMPLETION DATA:

- (1) diameter (inches) 4
- (2) total depth (feet) 59
- (3) static water level (feet) 25 below top of ground.
- (4) casing PVC, 49
(material) (depth)
4 if telescope see back.
(size)
- (5) screen 10, 49
(length) (depth to top)
4, PVC
(size) (material)
- (6) pump 1/2, 800
(HP) (yield gpm)
dia
(type power)
- (7) electric log _____
(yes or no)

(organization running log)

(8) how well bottom plugged And
Shut

DRILLERS REMARKS:


DEPT. OF NATURAL RESOURCES
BUREAU OF LAND & WATER RESOURCES

NOV 9 - 1981

RECEIVED

If well telescopes please sketch and show depths.

GROUND LEVEL

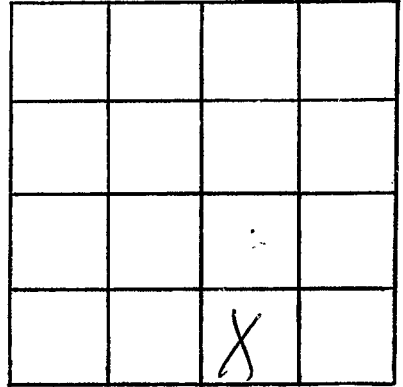

SECTION _____

Please indicate well location X.

ADDITIONAL INFORMATION

If more than one screen,
show locations of each on sketch.