

MISSISSIPPI DEPARTMENT OF NATURAL RESOURCES
 Bureau of Land and Water Resources
 Southport Mall
 P.O. Box 10631
 Jackson, Mississippi 39209
WATER WELL DRILLERS LOG

Pearl River
N
2008

1-12- 1983 Gulf Coast Waterwell Pearl River
 date well completed firm name county well located

LANDOWNER: Ben Kemp
2000 Effie St
Houma LA
 (mailing address)
 WELL LOCATION: Lot 232
 sec. 26 T-3 N R-14 E
 (S) (W)
14 miles EAST of POPLARVILLE
 (distance) (direction) (nearest town)

description of formations encountered	from	to
<u>TOP SOIL</u>		<u>2</u>
<u>CLAY</u>	<u>2</u>	<u>17</u>
<u>SAND</u>	<u>17</u>	<u>60</u>
<u>CLAY</u>	<u>60</u>	<u>80</u>
<u>FINE SAND</u>	<u>80</u>	<u>150</u>
<u>COURSE SAND</u>	<u>150</u>	<u>170</u>

WELL PURPOSE: Home
 (home, irrigation, municipal, industrial)

WELL COMPLETION DATA:

(1) diameter (inches) 2

(2) total depth (feet) 170

(3) static water level (feet) 15 below above top of ground.

(4) casing PVC, 160
 (material) (depth)
2" if telescope see back.
 (size)

(5) screen 10', 160'
 (length) (depth to top)
2", PVC
 (size) (material)

(6) pump NONE INSTALLED
 (HP) (yield gpm)
 (type power)

(7) electric log NO
 (yes or no)
 (organization running log)

(8) how well bottom plugged PVC
SAND
SHARK

DEPT. OF NATURAL RESOURCES
 BUREAU OF LAND & WATER RESOURCES


FEB - 3 1983

RECEIVED

DRILLERS REMARKS:
Well Produced 189 gpm
AIR Pumping

If well telescopes please sketch and show depths.

GROUND LEVEL

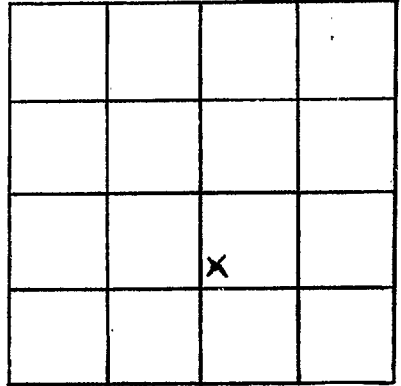

Lot # 232

SECTION 26

Please indicate well location X.

ADDITIONAL INFORMATION

If more than one screen,
show locations of each on sketch.