

MISSISSIPPI DEPARTMENT OF NATURAL RESOURCES

Bureau of Land and Water Resources

Southport Mall

P.O. Box 10631

Jackson, Mississippi 39209

WATER WELL DRILLERS LOG

Pearl River  
N 2013

1

Nov. 1 1984 date well completed  
Farnell Anderson firm name  
Pearl River county well located

LANDOWNER: Sid Bhansali  
Silver Run Lake  
Perkins, MS  
(mailing address)

description of formations encountered	from	to
TOP soil	0	2
Red clay	2	24
Sand	24	310
Clay Blue	30	86
Sand	86	116

WELL LOCATION:  
sec 23 T-3 S R-14 W  
11 miles S.E. of Poplarville  
(distance) (direction) (nearest town)

WELL PURPOSE: home  
(home, irrigation, municipal, industrial)

WELL COMPLETION DATA:

(1) diameter (inches) 2"

(2) total depth (feet) 116'

(3) static water level (feet) 80' below top of ground.


(4) casing PVC 111' (material) (depth)  
if telescope see back.

(5) screen 5' 111' (length) (depth to top)  
2" PVC (size) (material)

(6) pump 1 8 (HP) (yield gpm).  
Electric (type power)

(7) electric log NO (yes or no)  
(organization running log)

(8) how well bottom plugged capped

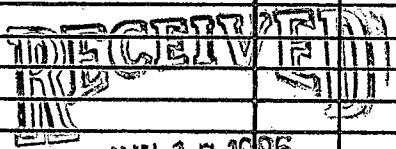


Department of Natural Resources  
Bureau of Land and Water Resources

DRILLERS REMARKS:

If well telescopes please sketch and show depths.

GROUND LEVEL

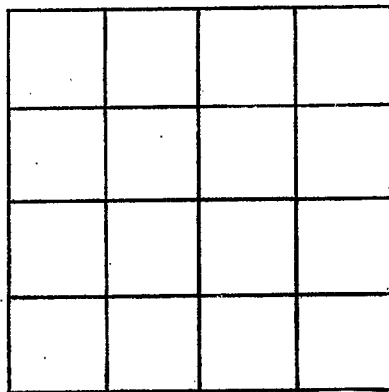

SECTION \_\_\_\_\_

Please indicate well location X.

ADDITIONAL INFORMATION

If more than one screen,  
show locations of each on sketch.