

MISSISSIPPI DEPARTMENT OF NATURAL RESOURCES

Bureau of Land and Water Resources

Southport Mall

P.O. Box 10631

Jackson, Mississippi 39209

WATER WELL DRILLERS LOG

PEARL RIVER  
N 2015

April 5 1986 Ward Well Dr. Pearl River  
date well completed firm name county well located

LANDOWNER: Harry Carter  
Rt. 2, Box 119  
Poplarville, Ms.  
(mailing address)


description of formations encountered	from	to
	<u>Sandy-clay</u>	<u>0</u>
<u>Red gravel - 1st</u>	<u>44</u>	<u>76</u>

WELL LOCATION:  
sec. 12 T. 3 N. R. 14 E  
7 miles S/E of Poplarville  
(distance) (direction) (nearest town)

WELL PURPOSE: Hand Pump!  
(home, irrigation, municipal, industrial)


- WELL COMPLETION DATA:
- (1) diameter (inches) 2"
  - (2) total depth (feet) 76'
  - (3) static water level (feet) 49' <sup>below</sup> above top of ground.
  - (4) casing PVC, 66  
(material) (depth)
  - (size) if telescope see back.
  - (5) screen 10'  
(length) (depth to top)
  - 2", PVC  
(size) (material)
  - (6) pump Hand Pump - 2  
(HP) (yield gpm)
  - (type power)
  - (7) electric log NO  
(yes or no)
  - N/A  
(organization running log)
  - (8) how well bottom plugged BWD

DRILLERS REMARKS: N/A

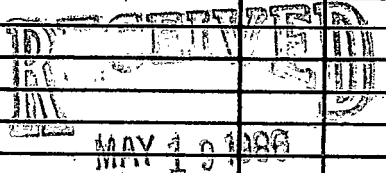

If well telescopes please sketch and show depths.

GROUND LEVEL

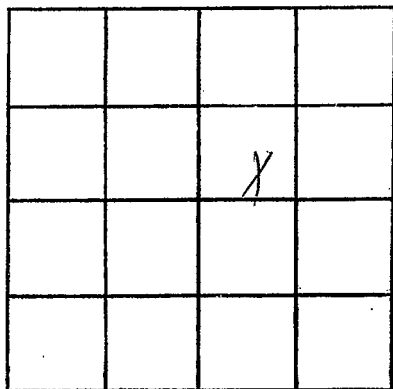

SECTION 12

Please indicate well location X.

ADDITIONAL INFORMATION

If more than one screen,  
show locations of each on sketch.