

# MISSISSIPPI DEPARTMENT OF NATURAL RESOURCES

Bureau of Land and Water Resources

P.O. Box 10631

Jackson, Mississippi 39209

WATER WELL DRILLERS LOG

COUNTY WELL LOCATED  
PEARL RIVER  
 WELL NUMBER N 2017 CODED  
 DATE WELL COMPLETED  
7-16-87

PERMIT NUMBER  
 NAME OF DRILLING FIRM  
WALKER'S WELL DRILLING

NAME & MAILING ADDRESS OF LANDOWNER  
STEVEN CADNER  
POBACARVILLE MISS  
 WELL LOCATION: SEC 32 TOWNSHIP 3 RANGE 14  
 DISTANCE 6 Miles DIRECTION S of NEAREST TOWN POBACARVILLE  
 OTHER LANDMARK  
AIRPORT  
 WELL PURPOSES Home, Irrigation, Municipal, Industrial, Fish Pond, etc.

PUMP DATA  
 PUMP-TYPE (Circle One):  
 Submersible, Turbine, Jet Flowing Well, Other (Describe)  
 POWER TYPE (Circle One):  
Electric Tractor, Diesel, Gasoline, Butane, Other (Describe)  
 Pump Capacity (GPM) No. of Stages Setting Depth  
 \_\_\_\_\_ 2 120 FT.  
 PUMP TEST  
 Well yielded \_\_\_\_\_ GPM with a drawdown of \_\_\_\_\_ ft. after \_\_\_\_\_ hours of pumping

WELL DATA  
 Well Depth 276 Casing Diameter (In.) 2" Casing Length (Ft.) 266  
 Type of Casing PVC Hole Depth 276 Depth to Static Water Level 114'  
 TYPE OF COMPLETION: (Circle One or More):  
 Gravel Packed, Underreamed, Telescoped, Natural Development, Open Hole, Other  
 (Describe) ATR  
 Top of Lap Pipe or Reduction in Casing  
 FEET IF TELESCOPED OR MORE THAN ONE SCREEN: USE BACK PAGE

LOG DATA  
 TYPE OF LOG RUN (Circle One): No Log Run, Electric, Gamma Ray, Density, Sonic, Neutron, Other (Describe)  
 Name of Organization Running Log

SCREEN DATA  
 Diameter - Inches 2 Length - Feet 10' Slot Size - Inches #10  
 Screen Type SLOT Depth to Bottom - Feet 276

GEOLOGIC DATA (Office Use Only)

Surface Elev.	Geologic Unit	Unit Thickness	Depth to Top
Subs. SWL	Date	Analysis	Aquifer Test

Driller's Remarks

**RECEIVED**

DESCRIPTION OF FORMATIONS ENCOUNTERED	FROM	TO	FORMATIONS (Continued)	FROM	TO
CLAY	0	70			
BLACK CLAY	70	160			
SAND	160	165			
BLUE CLAY	165	195			
SAND	195	225			


IF MORE SPACE IS NEEDED, USE BACK

AUG 03 1987

Department of Natural Resources  
 Bureau of Land & Water Resources

If well telescopes please  
sketch and show depths.

GROUND LEVEL

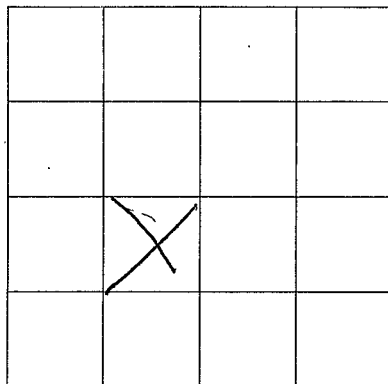

SECTION \_\_\_\_\_

Please indicate well location X.

ADDITIONAL INFORMATION

If more than one screen,  
show location of each on sketch.