

MISSISSIPPI DEPARTMENT OF NATURAL RESOURCES

Bureau of Land and Water Resources

Southport Mall

P.O. Box 10631

Jackson, Mississippi 39209

WATER WELL DRILLERS LOG

P. R. Jek
N 0018

4/24/89 date well completed 89 Bud Penton firm name Pearl River county well located

LANDOWNER: <u>Farrell Beckum</u>	description of formations encountered	from	to
<u>R.T. 2 Box 288</u>	<u>Red shale</u>	<u>0</u>	<u>6-</u>
<u>Poplarville, Miss.</u> (mailing address)	<u>Red sand</u>	<u>6-</u>	<u>40</u>
WELL LOCATION: sec. <u>33</u> T. <u>3</u> N R. <u>14</u> E S W	<u>White shale</u>	<u>57</u>	<u>80</u>
<u>6</u> miles <u>East</u> of <u>Poplarville</u> (distance) (direction) (nearest town)	<u>White sand</u>	<u>80</u>	<u>145-</u>
WELL PURPOSE: <u>Home</u> (home, irrigation, municipal, industrial)	<u>Blue shale</u>	<u>145</u>	<u>205</u>
WELL COMPLETION DATA:	<u>Gray sand</u>	<u>205</u>	<u>294</u>
(1) diameter (inches) <u>4</u>			
(2) total depth (feet) <u>300</u>			
(3) static water level (feet) <u>170</u> below above top of ground.			
(4) casing <u>PVC 300</u> (material) (depth)			
<u>4x2</u> if telescope see back. (size)			
(5) screen <u>10</u> <u>290</u> (length) (depth to top)			
<u>12</u> (size) (material)			
(6) pump <u>1</u> <u>20</u> (HP) (yield gpm)			
<u>Elect</u> (type power)			
(7) electric log <u>no</u> (yes or no)			
(organization running log)			
(8) how well bottom plugged <u>hard</u>			

RECEIVED

MAY 24 1989


Department of Natural Resources
Bureau of Land & Water Resources

DRILLERS REMARKS:

If well telescopes please sketch and show depths.

GROUND LEVEL

100' x 2" | 200' x 4" |

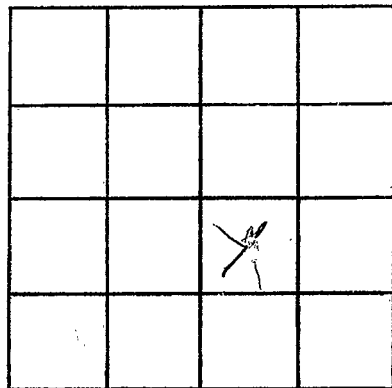

SECTION _____

Please indicate well location X.

ADDITIONAL INFORMATION

If more than one screen, show locations of each on sketch.