

MISSISSIPPI DEPARTMENT OF NATURAL RESOURCES

Bureau of Land and Water Resources

Southport Mall

P.O. Box 10631

Jackson, Mississippi 39209

WATER WELL DRILLERS LOG

P. RIVER
N 2019

9/5
date well completed

1989 Budget Services
firm name

Pearl River
county well located

LANDOWNER: Brash Griffin

description of formations encountered

from

to

Rt. 3 Elain or 72 330

Red shale

~~0~~ 2

Poplarville Miss.
(mailing address)

Red sand

8 30

Blue shale

30 177

Grey sand

177 246

WELL LOCATION:


sec. 36 T 3 N R 14 E
S W
12 miles North Poplarville
(distance) (direction) (nearest town)

WELL PURPOSE:

(home, irrigation, municipal, industrial) home

WELL COMPLETION DATA:

- (1) diameter (inches) 4"
- (2) total depth (feet) 246
- (3) static water level (feet) 188 below above top of ground.
- (4) casing PVC, 246,
(material) (depth)
- 4 1/2 if telescope see back.
(size)
- (5) screen 15, 231
(length) (depth to top)
- 12, PVC
(size) (material)
- (6) pump 1 1/2, 16
(HP) (yield gpm)
- Elect
(type power)
- (7) electric log no
(yes or no)

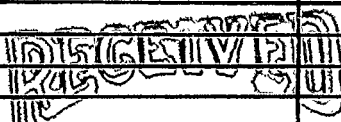

JAN 26 1990

(organization running log)

(8) how well bottom plugged see log
Brash

DRILLERS REMARKS:

If well telescopes please sketch and show depths.

GROUND LEVEL

			X

SECTION _____

Please indicate well location X.

ADDITIONAL INFORMATION

If more than one screen,
show locations of each on sketch.