

MISSISSIPPI DEPARTMENT OF NATURAL RESOURCES

Bureau of Land and Water Resources

Southport Mall

P.O. Box 10631

Jackson, Mississippi 39209

WATER WELL DRILLERS LOG

Pearl River  
N 2020

2/14

19

92 Bud Perton

firm name

Pearl River

county well located

LANDOWNER:

Gary Stearns

description of formations encountered

from

to

Foots Steven Rd

Red Shale

0

13

Poplarwill ms.

Red Sand

13

21

(mailing address)

White Shale

21

57

Red Sand

57

81

Blue Shale

81

142

White Sand

142

228

WELL LOCATION:

sec 31 T 3 N R 14 E

S W

10 miles

(distance)

East Poplarwill

(direction)

(nearest town)

WELL PURPOSE:

home

(home, irrigation, municipal, industrial)

WELL COMPLETION DATA:

(1) diameter (inches) 2

(2) total depth (feet) 228

(3) static water level (feet) 48 below above top of ground.

(4) casing pvc 228 (material) (depth)

(size) if telescope see back.

(5) screen 10 218 (length) (depth to top)

12 pvc (size) (material)

(6) pump 1 450 (HP) (yield gpm)

Elect (type power)

(7) electric log no (yes or no)

(organization running log)

(8) how well bottom plugged Sand



APR 29 1992


Dept. of Environmental Quality  
Bureau of Land & Water Resources

DRILLERS REMARKS:

Shark

If well telescopes please sketch and show depths.

GROUND LEVEL

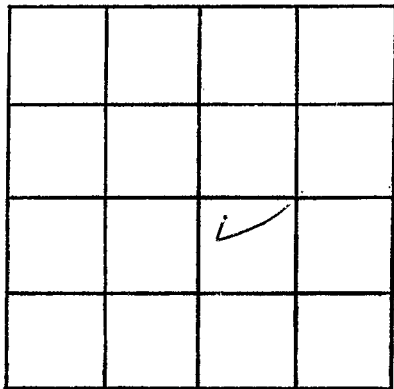

SECTION 31

Please indicate well location X.

ADDITIONAL INFORMATION

If more than one screen,  
show locations of each on sketch.