

MISSISSIPPI DEPARTMENT OF ENVIRONMENTAL QUALITY

Office of Land and Water Resources

P. O. Box 10631

Jackson, MS 39289-0631

MS. WATER WELL DRILLERS LOG

COUNTY WELL LOCATED Pearl River	
WELL NUMBER N 2023	CODED
DATE WELL COMPLETED 5-18-96	

PERMIT NUMBER
NAME OF DRILLING FIRM Moore's Water Well Serv.
31 R Moore Rd Wiggins, MS.

NAME & MAILING ADDRESS OF LANDOWNER Christopher Ladner 20 Wayne Ladner Rd Poolerville, MS 39470			
WELL LOCATION:	SEC	TOWNSHIP	RANGE
	2	3	S 14 W
DISTANCE	DIRECTION	NEAREST TOWN	
8 Miles	S	of Magnolia Comm	
OTHER LANDMARK Red Hill Baptist Church			
WELL PURPOSE (Home) Irrigation, Municipal, Industrial, Fish Pond, etc.			

PUMP DATA		
PUMP TYPE (Circle One): Submersible, Turbine, Jet Flowing Well, Other (Describe)		
POWER TYPE (Circle One): Electric Tractor, Diesel, Gasoline, Butane, Other (Describe) H/P		
Pump Capacity (GPM) 139pm.	No. of Stages 3	Setting Depth 60' FT.
PUMP TEST		
Well yielded _____ GPM with a drawdown of _____ ft. after _____ hours of pumping		

WELL DATA		
Well Depth 86'	Casing Diameter (In.) 2"	Casing Length (Ft.) 76'
Type of Casing R PVC	Hole Depth 86'	Depth to Static Water Level 29'
TYPE OF COMPLETION: (Circle One or More): Natural Development , Gravel-Packed, Underreamed, Telescoped, Open Hole, Other (Describe)		
WELL GROUTED TO A DEPTH OF 10 FEET Type Grout (circle one): Cement, Bentonite, or Mix		

LOG DATA	
TYPE OF LOG RUN (Circle One): Electric , No Log Run, Gamma Ray, Density, Sonic, Neutron, Other (Describe)	
Name of Organization Running Log	

SCREEN DATA		
Diameter - Inches 2"	Length - Feet 10'	Slot Size - Inches .10
Screen Type PVC Sch. 40		Depth to Bottom - Feet 86'


GEOLOGIC DATA (Office Use Only)			
Surface Elev.	Geologic Unit	Unit Thickness	Depth to Top
Subs. SWL	Date	Analysis	Aquifer Test
Driller's Remarks			

DESCRIPTION OF FORMATIONS ENCOUNTERED	FROM	TO
top soil	0'	3'
red & white soapstone	3'	17'
coarse sand & peagravel	17'	86'

FORMATIONS (Continued)	FROM	TO
RECEIVED		
JUN 12 1996		
Dept. of Environmental Quality Office of Land & Water Resources		
IF MORE SPACE IS NEEDED, USE BACK		

If well telescopes please
sketch and show depths.

GROUND LEVEL

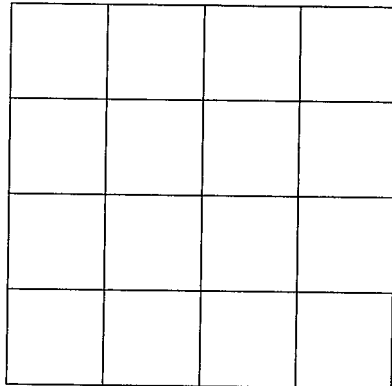

SECTION _____

Please indicate well location X.

ADDITIONAL INFORMATION

If more than one screen,
show location of each on sketch.