

Pearl River
 Φ 1
 3-69

MISSISSIPPI
 BOARD OF WATER COMMISSIONERS
 416 North State Street
 Jackson, Mississippi 39201

CODER

WATER WELL DRILLERS LOG

3-24 1969 Penton well serv Pearl River
 date well completed firm name county well located

LANDOWNER: O.C. Smith
Rt. 1 Box 98A
Carriere Miss
 (mailing address)

description of formations encountered	from	to
Red Clay	0	32
Sand	32	50
White Clay	50	87
Blue Clay	87	255
Grey Sand	255	285

WELL LOCATION:
 sec. 11 T. 4 S. R. 18 E. W.
5 miles South of Crossroads
 (distance) (direction) (nearest town)

WELL PURPOSE: Home
 (home, irrigation, municipal, industrial)

- WELL COMPLETION DATA:
- (1) diameter (inches) 2"
 - (2) total depth (feet) 285
 - (3) static water level (feet) 168 below ~~above~~ top of ground.
 - (4) casing Galv, 280
 (material) (depth)
2" If telescope see back.
 (size)
 - (5) screen 5', 280
 (length) (depth to top)
2", 3, Steel
 (size) (material)
 - (6) pump 1 1/2, 4 1/2
 (HP) (yield gpm)
Elec
 (type power)
 - (7) electric log NO
 (yes or no)
 (organization running log)
 - (8) how well bottom plugged BW Galv

CODER


MAR 24 1969

DRILLERS REMARKS:

Miss. Bd. of
 WATER WORKS

If well telescopes please
sketch and show depths.

GROUND LEVEL

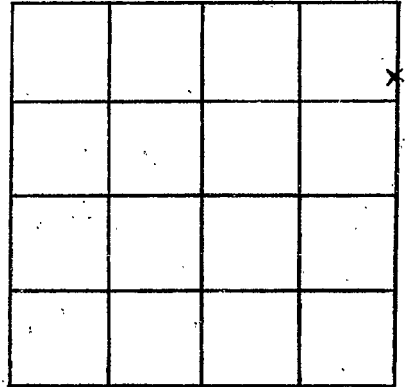

SECTION 11

Please indicate well location X.

ADDITIONAL INFORMATION

If more than one screen,
show locations of each on sketch.