

PEARL RIVER
 4
 9-18-69

MISSISSIPPI
 BOARD OF WATER COMMISSIONERS
 416 North State Street
 Jackson, Mississippi 39201

CODED

WATER WELL DRILLERS LOG

NEIL LUMPKIN WELL DRILLING SERVICE
 P. O. BOX 117
 CARROLLTON, MISS.

9-18-1969
 date well completed

PEARL RIVER
 county well located

LANDOWNER: Fred Jarrell
Carriere, Route 1
 (mailing address)

description of formations encountered	from	to
Surface clay	0	10
" sand (good to better)	10	70

WELL LOCATION:
 sec 2 T 4 R 13
3 miles South of North Crossroads
 (distance) (direction) (nearest town)

WELL PURPOSE: none
 (home, irrigation, municipal, industrial)

- WELL COMPLETION DATA:
- (1) diameter (inches) 4"
 - (2) total depth (feet) 70
 - (3) static water level (feet) 40' below top of ground.
 - (4) casing plastic
 (material) (depth)
4" if telescope see back.
 (size)
 - (5) screen 10'
 (length) (depth to top)
4" plastic
 (size) (material)
 - (6) pump 1/2 600 gph.
 (HP) (yield gpm)
electric
 (type power)
 - (7) electric log no
 (yes or no)

(organization running log)

(8) how well bottom plugged Johnson
AP Valve


DRILLERS REMARKS:

NOV 10 1969

MISS. BD. OF
 WATER COMM.

If well telescopes please
sketch and show depths.

GROUND LEVEL

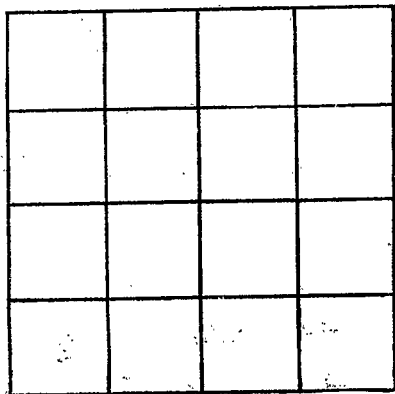

SECTION _____

Please indicate well location X.

ADDITIONAL INFORMATION

If more than one screen,
show locations of each on sketch.