

CODED

MISSISSIPPI  
BOARD OF WATER COMMISSIONERS  
416 North State Street  
Jackson, Mississippi 39201

PEARL RIVER  
Ø 5  
7-30-70

WATER WELL DRILLERS LOG

July 30, 1970 data well completed  
20 Esley Stafford's Well firm name  
Pearl River county well located

LANDOWNER: <u>Olis B. Lee Sr</u>	description of formations encountered	from	to
<u>Route 1</u>			
<u>Carristone, Miss</u> (mailing address)	<u>Sand &amp; Gravel</u>	<u>0</u>	<u>60</u>
WELL LOCATION: sec. <u>14</u> T. <u>4</u> S. R. <u>18</u> W. <u>263</u>	<u>Blue Chalk</u>	<u>60</u>	<u>120</u>
(distance) miles _____ of _____ (direction) of _____ (nearest town)	<u>Sand &amp; Gravel</u>	<u>120</u>	<u>150</u>
WELL PURPOSE: (home, irrigation, municipal, industrial)			
WELL COMPLETION DATA:			
(1) diameter (inches) <u>4 in</u>			
(2) total depth (feet) <u>150</u>			
(3) static water level (feet) <u>130</u> below top of ground.			
(4) casing <u>Plastic</u> , <u>140</u> (material) (depth) <u>4 in</u> (size) if telescope see back.			
(5) screen <u>10 ft</u> , <u>140 ft</u> (length) (depth to top) <u>4 in</u> , <u>Plastic</u> (size) (material)			
(6) pump <u>3/4</u> , <u>25</u> (HP) (yield gpm) <u>Elec</u> (type power)			
(7) electric log _____ (yes or no)			
_____ (organization running log)			
(8) how well bottom plugged <u>B.W.V.</u>			
DRILLERS REMARKS: <u>Cheryl Duncan</u>			


CODED

AUG 31 1970

MISS. BD. OF  
WATER COMM.

If well telescopes please sketch and show depths.

GROUND LEVEL

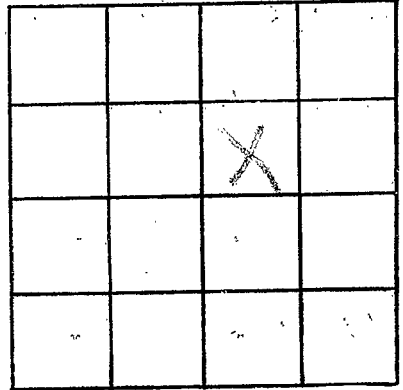

SECTION \_\_\_\_\_

Please indicate well location X.

ADDITIONAL INFORMATION

A series of horizontal lines for writing additional information, starting below the 'ADDITIONAL INFORMATION' header and extending to the bottom of the page.

If more than one screen, show locations of each on sketch.