

PEARL RIVER

06

8-6-70

MISSISSIPPI BOARD OF WATER COMMISSIONERS 416 North State Street Jackson, Mississippi 39201

CODED

WATER WELL DRILLERS LOG

Aug 6, 1970 date well completed Esley Stafford Well Service Pearl River firm name county well located

LANDOWNER: <u>Mrs. Lorraine D. B. Esley</u>	description of formations encountered	from	to
<u>RT 1, Box 244</u>			
<u>Carriens, Miss, 37426</u> (mailing address)	<u>Chalk</u>	<u>0</u>	<u>15</u>
<u>WELL LOCATION:</u> sec <u>14</u> T <u>4</u> S R <u>13</u> W <u>263</u>	<u>Sand &amp; gravel</u>	<u>15</u>	<u>65</u>
(distance) miles (direction) of (nearest town)			

WELL PURPOSE: home  
(home, irrigation, municipal, industrial)

WELL COMPLETION DATA:

- (1) diameter (inches) 4 in
- (2) total depth (feet) 65 ft
- (3) static water level (feet) 45 below top of ground.
- (4) casing plastic, 65'  
(material) (depth)  
17 in if telescope see back.  
(size)
- (5) screen 10 ft, 5.5 ft  
(length) (depth to top)  
4 in, plastic  
(size) (material)
- (6) pump 1/2 20  
(HP) (yield gpm)  
elec  
(type power)
- (7) electric log \_\_\_\_\_  
(yes or no)  
  
(organization running log)
- (8) how well bottom plugged B.W.V.

CODED


AUG 31 1970

DRILLERS REMARKS:  
Cleve Duncan

MISS. BD. OF WATER COMM.

If well telescopes please sketch and show depths.

GROUND LEVEL

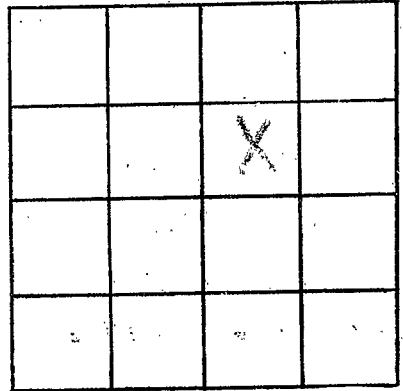

SECTION \_\_\_\_\_

Please indicate well location X.

ADDITIONAL INFORMATION

If more than one screen, show locations of each on sketch.