

Pearl River
 07
 6-10-70

MISSISSIPPI
 BOARD OF WATER COMMISSIONERS
 416 North State Street
 Jackson, Mississippi 39201

CODED

WATER WELL DRILLERS LOG

6-10-70 date well completed E. J. Worster Well Serv. firm name Pearl River county well located

LANDOWNER:
 Oliver Wilson
 Rt. 1 Corriere Miss.
 (mailing address)

description of formations encountered	from	to
Red clay	0	16
Red & white sd.	16	65
Sd & Red. Clay str.	65	80
white co. sd.	80	90

WELL LOCATION:
 sec. 26 T 4 N R 18 E
 10 miles west of Newell
 (distance) (direction) (nearest town)

WELL PURPOSE: Home
 (home, irrigation, municipal, industrial)

WELL COMPLETION DATA:

(1) diameter (inches) 4.5

(2) total depth (feet) 89

(3) static water level (feet) 63 below top of ground.

(4) casing Galv. 84' (material) (depth)
 If telescope see back.
 (size)

(5) screen 5' 84-9' (length) (depth to top)
 2" 55' (size) (material)

(6) pump 2 250 (HP) (yield gpm)
 Elect (type power)

(7) electric log NO (yes or no)

(organization running log)

(8) how well bottom plugged shoe

CODED


JUL 28 1970

DRILLERS REMARKS:

MISS. BD. OF
 WATER COMMISSIONERS

If well telescopes please sketch and show depths.

GROUND LEVEL

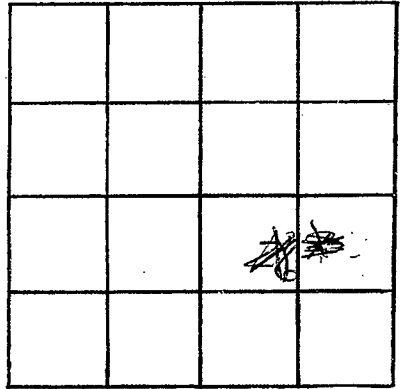

SECTION: 26

Please indicate well location X.

ADDITIONAL INFORMATION

If more than one screen,
show locations of each on sketch.