

PEARL RIVER

Ø 10

3-8-71

MISSISSIPPI
 BOARD OF WATER COMMISSIONERS
 416 North State Street
 Jackson, Mississippi 39201

CODED

WATER WELL DRILLERS LOG

3-8 1971
date well completed

71 E. J. Warner rd. N. Pearl River
firm name county well located

LANDOWNER:	description of formations encountered	from	to
Horace Stewart	Red Clay	0	18
Horace Stewart Mailing address	yellow clay	18	30
WELL LOCATION: sec. 23 T. 4 N. R. 18 E. 10 miles west of McNeil	med Red sd.	30	50
(distance) (direction) (nearest town)	white sd. & Gravel	50	71
WELL PURPOSE: Home (home, irrigation, municipal, industrial)			
WELL COMPLETION DATA:			
(1) diameter (inches) 4 1/2"			
(2) total depth (feet) 71'			
(3) static water level (feet) 41' below top of ground.			
(4) casing Plastic 66. (material) (depth)			
4" if telescope see back. (size)			
(5) screen 5' 66-71' (length) (depth to top)			
4" Plastic (size) (material)			
(6) pump 1 600 G.P.M. (HP) (yield gpm)			
Elect (type power)			
(7) electric log NO (yes or no)			
(organization running log)			
(8) how well bottom plugged Shoe			

CODED


FRIDAY 11 7 1971

MISS. Bd. of Water Comm.
MADE IN MISSISSIPPI

DRILLERS REMARKS:

If well telescopes please sketch and show depths.

GROUND LEVEL

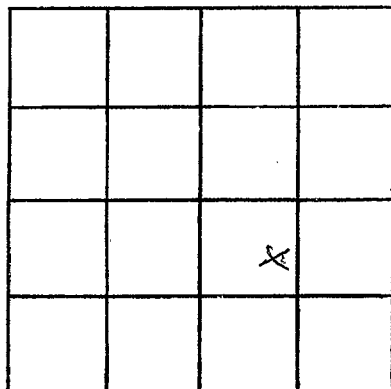

SECTION 23

Please indicate well location X.

ADDITIONAL INFORMATION

If more than one screen,
show locations of each on sketch.