

Pearl River
012
12-20-71

MISSISSIPPI
 BOARD OF WATER COMMISSIONERS
 416 North State Street
 Jackson, Mississippi 39201

WATER WELL DRILLERS LOG

CODED

12-20 1971 Bud Kenters Son Pearl River
 date well completed firm name county well located

LANDOWNER:

Charles White

description of formations encountered

from

to

Rt. 1
Carriere, Miss.
 (mailing address)

<u>Red Shale</u>	<u>0</u>	<u>36</u>
<u>Red Sand</u>	<u>36</u>	<u>61</u>
<u>Rocky Sand</u>	<u>61</u>	<u>73</u>

WELL LOCATION:

sec. 24 T 4 N R. 18 E
6 miles W of Carriere
 (distance) (direction) (nearest town)

WELL PURPOSE:

Home
 (home, irrigation, municipal, industrial)

WELL COMPLETION DATA:

- (1) diameter (inches) 2 in
- (2) total depth (feet) 73 ft
- (3) static water level (feet) 51 below above top of ground.
- (4) casing PVC 68
 (material) (depth)
 (size) if telescope see back.
- (5) screen 5 ft 68
 (length) (depth to top)
2x5 PVC no. 2
 (size) (material)
- (6) pump 1 350
 (HP) (yield gpm)
electric
 (type power)
- (7) electric log no
 (yes or no)

CODED

(organization running log)

(8) how well bottom plugged Sand Shad


JAN 31 1972

MISS. BD. OF WATER COMMISSIONERS

DRILLERS REMARKS:

If well telescopes please
sketch and show depths.

GROUND LEVEL

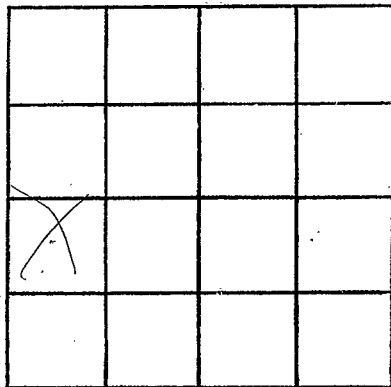

SECTION _____

Please indicate well location X.

ADDITIONAL INFORMATION

If more than one screen,
show locations of each on sketch.