

CODED

PEARL River
Ø 13
11-18-71

MISSISSIPPI
BOARD OF WATER COMMISSIONERS
416 North State Street
Jackson, Mississippi 39201

WAR 9 1972

WATER WELL DRILLERS LOG

11-18 1971 Neil Rumphin Well Pearl River
date well completed firm name county well located
Harold Richardson

LANDOWNER: Harold Richardson
Carriere, Miss.
Route 1
(mailing address)

Description of formations encountered	from	to
	0	20
	20	60
	60	200
	200	268

WELL LOCATION:
sec. 12 T. 4 S. R. 18 W.
6 miles West of McNeill
(distance) (direction) (nearest town)

WELL PURPOSE: Cattle farm
(home, irrigation, municipal, industrial)


- WELL COMPLETION DATA:
- (1) diameter (inches) 2"
 - (2) total depth (feet) 268'
 - (3) static water level (feet) 140 below above top of ground.
 - (4) casing galv. (material), (depth) 2" if telescope see back. (size)
 - (5) screen 5' (length), (depth to top) 2" (size), 3. Steel (material)
 - (6) pump 100 HP (HP), 280 gpm (yield gpm), electric (type power)
 - (7) electric log no (yes or no)
- (organization running log)
- (8) how well bottom plugged Johnson
B. P. Valrie

CODED

DRILLERS REMARKS:

If well telescopes please sketch and show depths.

GROUND LEVEL

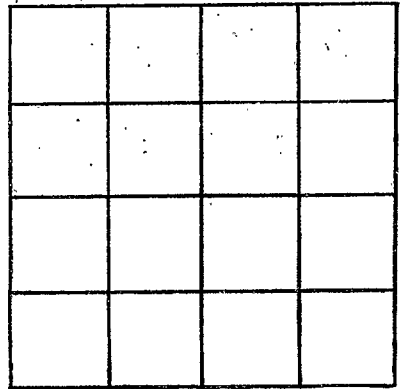

SECTION _____

Please indicate well location X.

ADDITIONAL INFORMATION

If more than one screen, show locations of each on sketch.