

**PEARL RIVER**  
 14  
 11-5-71

MISSISSIPPI  
 BOARD OF WATER COMMISSIONERS  
 416 North State Street  
 Jackson, Mississippi 39201

MAR 9 1972

WATER WELL DRILLERS LOG

MISS. Bd. of  
 WATER

11-5-71 1971 Neil D. Humphreys Well Pearl River  
 date well completed firm name county well located  
 Drilling Service

LANDOWNER: Ray Burge  
Carrier, Miss.  
Rt. 1, Box 220  
 (mailing address)

description of formations encountered	from	to
surface clay	0	20
sand	20	110
blue clay	110	180
good sand	180	210

WELL LOCATION:  
 sec. 23 T 4 S R 18 W  
12 miles west of Carrier  
 (distance) (direction) (nearest town)

WELL PURPOSE: home  
 (home, irrigation, municipal, industrial)

- WELL COMPLETION DATA:
- diameter (inches) 4'
  - total depth (feet) 210
  - static water level (feet) 150 below above top of ground.
  - casing plastic (material) (depth)  
4" if telescope see back.  
 (size)
  - screen 10' (length) (depth to top)  
4" (size) plastic (material)
  - pump 1 1/2 (HP) 500 gph (yield gpm)  
electric (type power)
  - electric log No (yes or no)
- (organization running log)


(8) how well bottom plugged Johnson  
A P Valves

DRILLERS REMARKS:

CODED

If well telescopes please sketch and show depths.

GROUND LEVEL

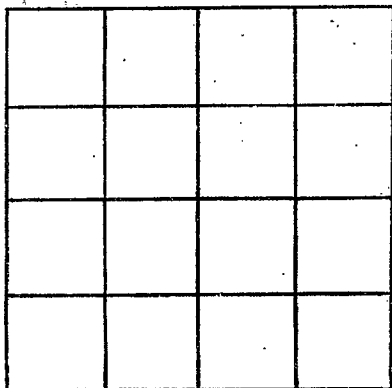

SECTION \_\_\_\_\_

Please indicate well location X.

ADDITIONAL INFORMATION

If more than one screen,  
show locations of each on sketch.