

PEARL RIVER
#15
4-12-72

MISSISSIPPI
 BOARD OF WATER COMMISSIONERS
 416 North State Street
 Jackson, Mississippi 39201

CODED

WATER WELL DRILLERS LOG

April 12 1972 Essley Stafford Water Well Service Pearl River
 date well completed firm name county well located

LANDOWNER: E. H. Wise
Rt. 1.

description of formations encountered from to

Carriers Miss
 (mailing address)

Topsoil & Clay 0 15

WELL LOCATION:
 sec 24 T 4 S R 18 W
8 miles South of Crossroad
 (distance) (direction) (nearest town)

Chalk 15 22
Sand & Gravel 22 6.5

WELL PURPOSE:
 (home, irrigation, municipal, industrial)

WELL COMPLETION DATA:

(1) diameter (inches) 4

(2) total depth (feet) 65

CODED

(3) static water level (feet) 40 below above top of ground.

(4) casing Plastic, 55.
 (material) (depth)

4 if telescope see back.
 (size)

(5) screen 10 ft, 55 ft
 (length) (depth to top)

4 in., Plastic
 (size) (material)

(6) pump 1/2 10
 (HP) (yield gpm)

Elco
 (type power)

(7) electric log _____
 (yes or no)

ADD 25 WIZ
 AT "

(organization running log)

(8) how well bottom plugged B.W.U.


MISS. DEPT. OF
 TRANSPORTATION
 JACKSON, MISS.

DRILLERS REMARKS
Charles Stafford

If well telescopes please sketch and show depths.

GROUND LEVEL

CODED

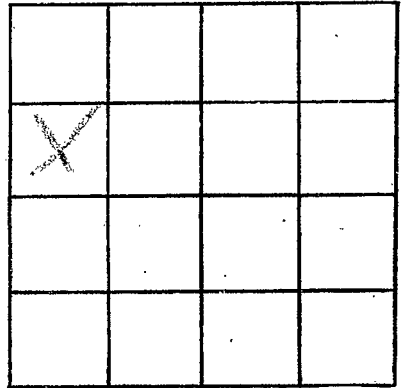

SECTION _____

Please indicate well location X.

ADDITIONAL INFORMATION

If more than one screen, show locations of each on sketch.