

PEARL RIVER
 17
 12-30-72

MISSISSIPPI
 BOARD OF WATER COMMISSIONERS
 416 North State Street
 Jackson, Mississippi 39201

CODED

WATER WELL DRILLERS LOG

NEIL LUMPKIN WELL DRILLING SERVICE
 P. O. BOX 117
 CARRIÈRE, MISS. *Pearl River*
 county well located

12-30-72
 date well completed

LANDOWNER: *Corder Poo*
Bank
Mr. Harold Richardson
Carriere Route
 (mailing address)

description of formations encountered	from	to
<i>Surface clay</i>	<i>0</i>	<i>10</i>
<i>Surface sand</i>	<i>10</i>	<i>130</i>
<i>Blue clay</i>	<i>130</i>	<i>190</i>
<i>Good sand</i>	<i>190</i>	<i>237</i>

WELL LOCATION:
 sec. *12* T. *4* S. R. *18* E.
7 miles *NW* of *M^{rs} Mull*
 (distance) (direction) (nearest town)

WELL PURPOSE: *Cattle farm*
 (home, irrigation, municipal, industrial)

WELL COMPLETION DATA:

- (1) diameter (inches) *4"*
- (2) total depth (feet) *237'*
- (3) static water level (feet) *150* below above top of ground.
- (4) casing *plastic*
 (material) (depth)
4"
 (size) if telescope see back.
- (5) screen *20'*
 (length) (depth to top)
4" *plastic*
 (size) (material)
- (6) pump *3 submers 3800 gph*
 (HP) (yield gpm)
electric
 (type power)
- (7) electric log *no*
 (yes or no)

(organization running log)


(8) how well bottom plugged *Sand*
shank B.P.V.

DRILLERS REMARKS:

JAN 11 1973

If well telescopes please sketch and show depths.

GROUND LEVEL

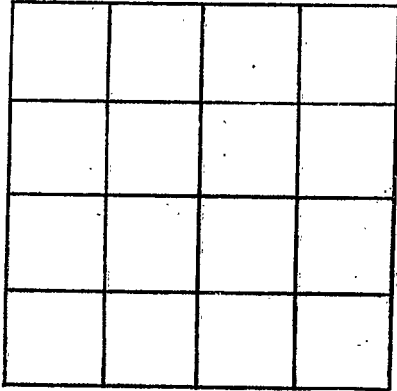

SECTION _____

Please indicate well location X.

ADDITIONAL INFORMATION

A series of horizontal lines providing space for additional information.

If more than one screen, show locations of each on sketch.