

P.R.
 D 18
 11-29-73

MISSISSIPPI
 BOARD OF WATER COMMISSIONERS
 416 North State Street
 Jackson, Mississippi 39201

WATER WELL DRILLERS LOG

CODED

11-29-1973 Bud Linton's Son Pearl River
 date well completed firm name county well located

LANDOWNER: John Rosen

Carrum, Miss.

description of formations encountered

from to

<u>Red Shale</u>	<u>0</u>	<u>11</u>
<u>Red Sand</u>	<u>11</u>	<u>45</u>
<u>Blue Shale</u>	<u>45</u>	<u>175</u>
<u>Blue Sand</u>	<u>175</u>	<u>190</u>

(mailing address)

WELL LOCATION:

sec. 39 T. 4 N. R. 18 E.
14 miles W of Carrum
 (distance) (direction) (nearest town)

WELL PURPOSE: Home
 (home, irrigation, municipal, industrial)

WELL COMPLETION DATA:

- (1) diameter (inches) 4 in
- (2) total depth (feet) 190
- (3) static water level (feet) 91 below above top of ground.
- (4) casing Pvc, 190
 (material) (depth)

(size) If telescope see back.

- (5) screen 4x10, 180
 (length) (depth to top)
4x10, Pvc 1012
 (size) (material)

- (6) pump 1 650
 (HP) (yield gpm)
electric
 (type power)


- (7) electric log NO
 (yes or no)

(organization running log)

- (8) how well bottom plugged Sand Shale

DRILLERS REMARKS:


CODED

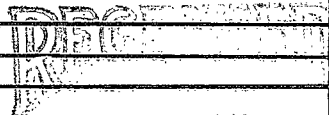

JAN 7 1974

If well telescopes please sketch and show depths.

GROUND LEVEL

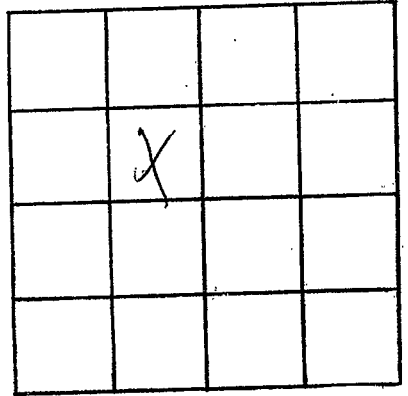

SECTION _____

Please indicate well location X.

ADDITIONAL INFORMATION

If more than one screen,
show locations of each on sketch.