

# PEARL RIVER MISSISSIPPI CODED BOARD OF WATER COMMISSIONERS

416 North State Street  
Jackson, Mississippi 39201

## WATER WELL DRILLERS LOG

① 20  
A-26-74

4-26-1977 date well completed  
Washbas Water Well firm name  
Pearl River county well located

LANDOWNER: R.J. Burgess  
Rt 1 Poplarville, Miss

(mailing address)

WELL LOCATION:

27 sec 4 T 18 R 18 E  
8 miles S of Crowfoot  
(distance) (direction) (nearest town)

WELL PURPOSE: home  
(home, irrigation, municipal, industrial)

WELL COMPLETION DATA:

- (1) diameter (inches) 4"
- (2) total depth (feet) 90'
- (3) static water level (feet) 50' below top of ground.
- (4) casing PVC 90'  
(material) (depth)

(size) if telescope see back.

- (5) screen 10' 80'  
(length) (depth to top)  
4" PVC  
(size) (material)

- (6) pump 1 12  
(HP) (yield gpm)  
Electric  
(type power)

- (7) electric log no  
(yes or no)

(organization running log)

- (8) how well bottom plugged Back  
Wash Valve

description of formations encountered

from

to

Top Soil	0	4
Clay	4	25
Sand (Fine)	25	65
Sand (Course)	65	90

CODED

REGISTERED


MAY 1978

MISS. Bd. of Water Comm.

DRILLERS REMARKS:

If well telescopes please sketch and show depths.

GROUND LEVEL

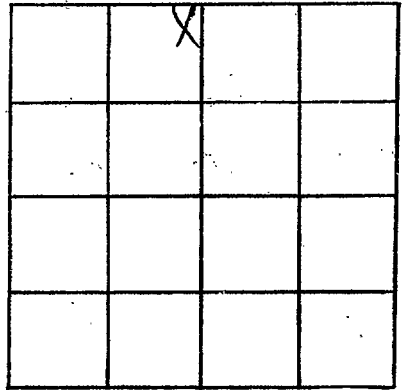

SECTION 27

Please indicate well location X.

ADDITIONAL INFORMATION

If more than one screen,  
show locations of each on sketch.