

PEARL RIVER
 021
 4-27-74

MISSISSIPPI
 BOARD OF WATER COMMISSIONERS
 416 North State Street
 Jackson, Mississippi 39201

CODED

WATER WELL DRILLERS LOG

4-27 1974 Mcabee water well being Pearl River
 date well completed firm name county well located

LANDOWNER: Wayne Mitchell
Rt 1 Poplarville, Miss
 (mailing address)

description of formations encountered	from	to
Clay	0	20
Muddy sand	20	55
sand	55	70

WELL LOCATION:
~~43~~ T 48 R 18
~~739~~ miles South of Crossroad
 (distance) (direction) (nearest town)

WELL PURPOSE: home
 (home, irrigation, municipal, industrial)

- WELL COMPLETION DATA:
- diameter (inches) ~~3~~ 4"
 - total depth (feet) 75
 - static water level (feet) 63 below above top of ground.
 - casing PVC, 75'
 (material) (depth)
 (size) if telescope see back.
 - screen 10', 65'
 (length) (depth to top)
4", PVC
 (size) (material)
 - pump 1/2, 15
 (HP) (yield gpm)
Electric
 (type power)
 - electric log no
 (yes or no)
 - (organization running log)
 - how well bottom plugged Barb
Wash Valve

CODED


RECORDED
 MAY - 3 1974

DRILLERS REMARKS:

MISS. DE. OF WATER CONTROL

If well telescopes please sketch and show depths.

GROUND LEVEL

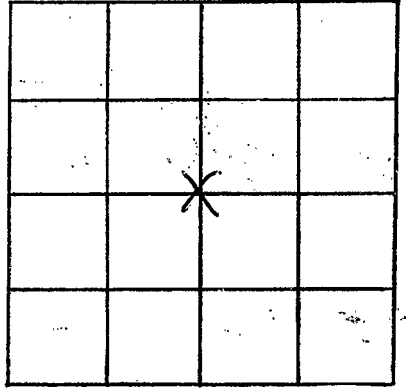

SECTION 39

Please indicate well location X.

ADDITIONAL INFORMATION

If more than one screen, show locations of each on sketch.