

P.R.
 #23
 5-15-74

MISSISSIPPI
 BOARD OF WATER COMMISSIONERS
 416 North State Street
 Jackson, Mississippi 39201

CODED

WATER WELL DRILLERS LOG

5/15 1974 Easley Stafford Well Dr. Peru River Co.
 date well completed firm name county well located

LANDOWNER: Danton Stewart
Crossroads, Miss.
 (mailing address)

WELL LOCATION:
 sec. 13 T. 4 N. R. 18 E.
2 miles East of Crossroads
 (distance) (direction) (nearest town)

WELL PURPOSE:
 (home, irrigation, municipal, industrial)


- WELL COMPLETION DATA:
- (1) diameter (inches) 2 in
 - (2) total depth (feet) 221 ft.
 - (3) static water level (feet) 15 ft. ^{Below} _{above} top of ground.
 - (4) casing 2 in, 201
 (material) (depth)
2 in if telescope see back.
 (size)
 - (5) screen 20 ft., 201 ft.
 (length) (depth to top)
2 in, Galvanize
 (size) (material)
 - (6) pump flow full 2 in
 (HP) (yield: gpm)
 (type power)
 - (7) electric log (yes or no)
 (organization running log)
 - (8) how well bottom plugged B.W.O.

description of formations encountered	from	to
	<u>Top soil</u>	<u>0</u>
<u>chalk.</u>	<u>20</u>	<u>60</u>
<u>Sand</u>	<u>20</u>	<u>80</u>
<u>chalk.</u>	<u>80</u>	<u>150</u>
<u>Sand & gravel</u>	<u>150</u>	<u>221</u>
CODED		
MAY 26 1974		
MISS. Bd. OF WATER COMMISSIONERS		

DRILLERS REMARKS:
Cleve Duran

If well telescopes please sketch and show depths.

GROUND LEVEL

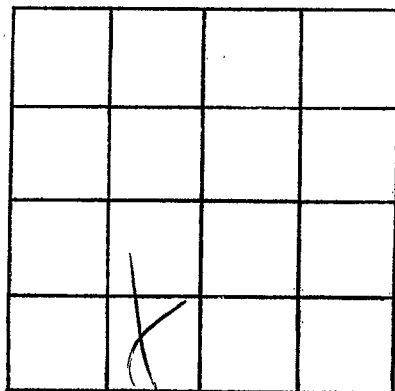

SECTION _____

Please indicate well location X.

ADDITIONAL INFORMATION

If more than one screen,
show locations of each on sketch.