

Pearl R.
 # 27
 2-14-75

MISSISSIPPI
 BOARD OF WATER COMMISSIONERS
 416 North State Street
 Jackson, Mississippi 39201

CODED

WATER WELL DRILLERS LOG

2-14 1975 Beal Contractors Paul Rine
 date well completed firm name county well located

LANDOWNER: Dessie Baker

description of formations encountered

from to

Rt. 1
Poplarville, Miss.
 (mailing address)

Red shale
Red sand
White shale
Blue shale
Gray sand

0	18
18	36
36	76
76	131
131	250

WELL LOCATION:


sec. 13 T 4 N R 18 E
16 miles W of Poplarville
 (distance) (direction) (nearest town)

WELL PURPOSE: Home
 (home, irrigation, municipal, industrial)

CODED

WELL COMPLETION DATA:

- (1) diameter (inches) 4
- (2) total depth (feet) 250
- (3) static water level (feet) 159 below above top of ground.
- (4) casing PVC, 240
 (material) (depth)
 (size) if telescope see back.
- (5) screen 4x10, 240
 (length) (depth to top)
4x10 PVC
 (size) (material)
- (6) pump 1 050
 (HP) (yield gpm)
electric
 (type power)
- (7) electric log no
 (yes or no)

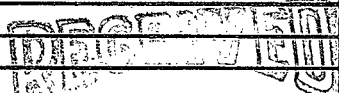


APR - 3 1975

DRILLERS REMARKS: Sand Shale

MISS. BD. OF WATER COMMISSIONERS

If well telescopes please sketch and show depths.

GROUND LEVEL

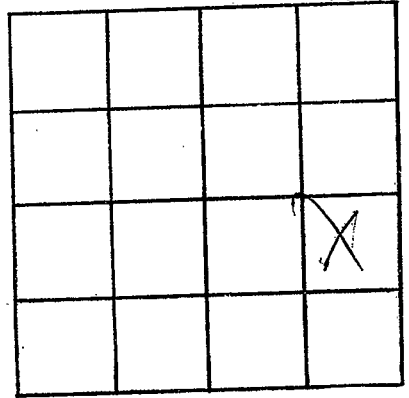

SECTION _____

Please indicate well location X.

ADDITIONAL INFORMATION

If more than one screen, show locations of each on sketch.