

Pearl River
D 28
5-2-75

MISSISSIPPI
 BOARD OF WATER COMMISSIONERS
 416 North State Street
 Jackson, Mississippi 39201

CODED

WATER WELL DRILLERS LOG

5-2 1975 Lumpkin Well Ser. Pearl River
 date well completed firm name county well located

LANDOWNER:	description of formations encountered	from	to
<u>Mr. Jack Smith</u> <u>Picayune, Ms.</u> (mailing address)			
	<u>Sand</u>	<u>15</u>	<u>35</u>
	<u>Clay</u>	<u>35</u>	<u>225</u>
	<u>Sand</u>	<u>225</u>	<u>247</u>
WELL LOCATION: <u>13V</u> sec <u>27</u> T <u>N</u> R <u>18</u> E <u>7</u> miles <u>NW</u> of <u>Picayune</u> (distance) (direction) (nearest town)			
WELL PURPOSE: <u>None</u> (home, irrigation, municipal, industrial)			
WELL COMPLETION DATA:			
(1) diameter (inches) <u>2"</u>			
(2) total depth (feet) <u>247'</u>			
(3) static water level (feet) <u>80</u> below/above top of ground.			
(4) casing <u>P.V.C.</u> <u>241'</u> (material) (depth)			
<u>2"</u> If telescope see back. (size)			
(5) screen <u>6</u> <u>241'</u> (length) (depth to top)			
<u>2"</u> <u>P.V.C.</u> (size) (material)			
(6) pump <u>1</u> <u>250GPH.</u> (HP) (yield gpm)			
<u>Elec.</u> (type power)			
(7) electric log <u>No.</u> (yes or no)			
<u>No</u> (organization running log)			
(8) how well bottom plugged <u>Sand Shrub</u>			
DRILLERS REMARKS:			


RECEIVED

JUL 14 1975

MISS. Bd. OF WATER COMM.

If well telescopes please sketch and show depths.

GROUND LEVEL

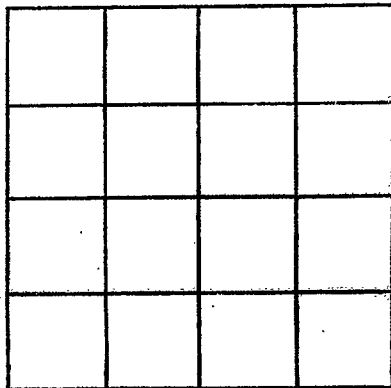

SECTION _____

Please indicate well location X.

ADDITIONAL INFORMATION

If more than one screen, show locations of each on sketch.