

Pearl River
 29
 4/28/77

MISSISSIPPI
 BOARD OF WATER COMMISSIONERS
 416 North State Street
 Jackson, Mississippi 39201

CODED

WATER WELL DRILLERS LOG

4/28
 date well completed

79 Bud penton & son Pearl River
 firm name county well located

LANDOWNER: Huger Broad
~~A. H. Bell~~
Picayune Miss.
 (mailing address)

description of formations encountered

from to

WELL LOCATION:
 sec. 15 T. 8 N R. 18 E
1.5 miles NW of Picayune
 (distance) (direction) (nearest town)

white shale	0	70
white sand	70	150
blue shale	150	422
blue sand	462	680
blue shale	680	872
gray sand	872	879
blue shale	879	1060
gray sand	1060	1119
blue shale	879	1060
gray sand	1060	1119

WELL PURPOSE: home
 (home, irrigation, municipal, industrial)

WELL COMPLETION DATA:

- (1) diameter (inches) 2"
- (2) total depth (feet) 1119
- (3) static water level (feet) 12 1/4 ^{below} _{above} top of ground.
- (4) casing Galv. 1099
 (material) (depth)
- _____ if telescope see back.
 (size)
- (5) screen 2x20, 1099
 (length) (depth to top)
18 st steel
 (size) (material)
- (6) pump no
 (HP) (yield gpm)
- _____ (type power)
- (7) electric log no
 (yes or no)

(8) how well bottom plugged shark sand
 (organization running log)

DRILLERS REMARKS:


CODED

RECEIVED

MISS. DE. OF WATER

If well telescopes please sketch and show depths.

GROUND LEVEL

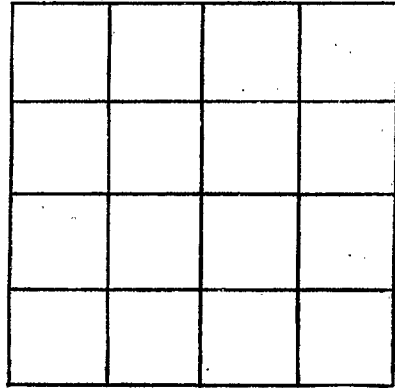

SECTION _____

Please indicate well location X.

ADDITIONAL INFORMATION

If more than one screen,
show locations of each on sketch.