

MISSISSIPPI DEPARTMENT OF NATURAL RESOURCES

Bureau of Land and Water Resources

Southport Mall

P.O. Box 10631

Jackson, Mississippi 39209

WATER WELL DRILLERS LOG

PEARL RIVER
Q 30

CODED

May 29, 84 ¹⁹ Walker Welding Pearl River
date well completed firm name county well located

LANDOWNER	description of formations encountered	from	to
Byrds Chapel	Red shell	0	57
United Methodist Ch	sand	57	78
R1 Carnine Miss	Blue shell	78	190
(mailing address)	sand	190	218
	Blue sand	218	288

WELL LOCATION:
sec. 11 T 4 N R. 18 E
18 miles NW Piquem
(distance) (direction) (nearest town)

WELL PURPOSE: Home
(home, irrigation, municipal, industrial)

- WELL COMPLETION DATA:
- (1) diameter (inches) 4"
 - (2) total depth (feet) 288
 - (3) static water level (feet) 165 below ~~chase~~ top of ground.
 - (4) casing PVC 260
(material) (depth)
 - 4x2 If telescope see back.
(size)
 - (5) screen 26' 260'
(length) (depth to top)
 - 2 PVC
(size) (material)
 - (6) pump 1
(HP) (yield gpm)
 - Elec
(type power)
 - (7) electric log 11
(yes or no)
 - (organization running log)
 - (8) how well bottom plugged sand
shank

CODED



DEPT. OF NATURAL RESOURCES
BUREAU OF LAND & WATER RESOURCES

JUN 18 1984
RECEIVED

DRILLERS REMARKS:

If well telescopes please sketch and show depths.

GROUND LEVEL

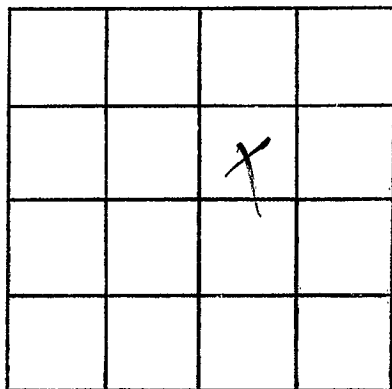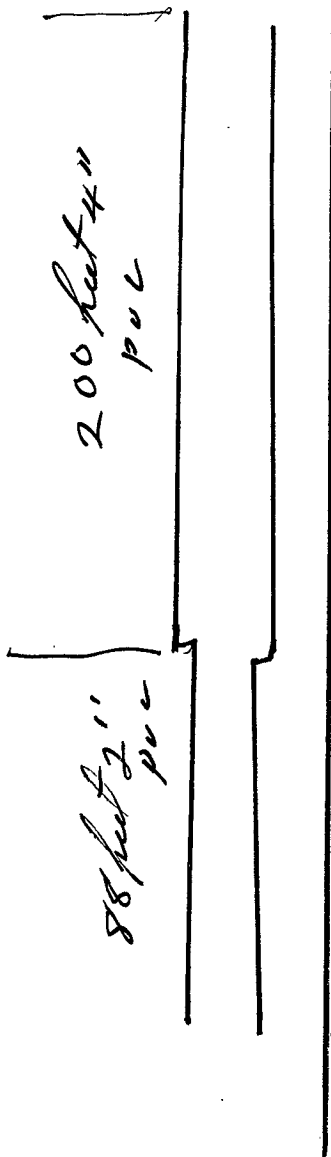

SECTION _____

Please indicate well location X.

ADDITIONAL INFORMATION

If more than one screen,
show locations of each on sketch.