

MISSISSIPPI DEPARTMENT OF NATURAL RESOURCES

Bureau of Land and Water Resources

Southport Mall

P.O. Box 10631

Jackson, Mississippi. 39209

WATER WELL DRILLERS LOG

WALKERS WELDING

PR

Pearl R.
 Ø 33
 5-6-85

5-6-1985 ~~DATE~~ date well completed firm name county well located

LANDOWNER: ELMER WISE
RT. 1
CARRIERE MISS
 (mailing address)
 WELL LOCATION:
 sec. 25 T 4 S R 18 W
11 miles W of CARRIERE
 (distance) (direction) (nearest town)

description of formations encountered	from	to
	CLAY	0
SAND & GRAVEL	17	36
CLAY	36	43
SAND	43	85

WELL PURPOSE: HOME
 (home, irrigation, municipal, industrial)

WELL COMPLETION DATA:
 (1) diameter (inches) 4 1/8
 (2) total depth (feet) 85
 (3) static water level (feet) 41 below top of ground.
 (4) casing PRC 35
 (material) (depth)
 _____ If telescope see back.
 (size)
 (5) screen 10 75
 (length) (depth to top)
4" PRC
 (size) (material)
 (6) pump 2 11
 (HP) (yield gpm)
ELEC.
 (type power)
 (7) electric log _____
 (yes or no)

 (organization running log)
 (8) how well bottom plugged SANDSHARK


DRILLERS REMARKS:

RECEIVED
 MAY 10 1985

Department of Natural Resources
 Bureau of Land & Water Resources

If well telescopes please sketch and show depths.

GROUND LEVEL

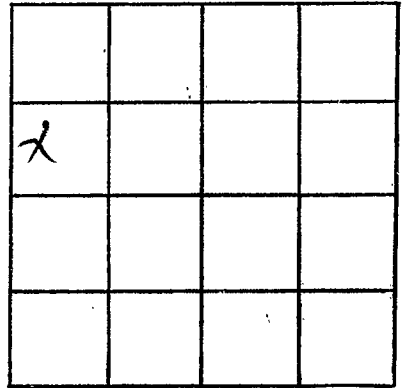

SECTION _____

Please indicate well location X.

ADDITIONAL INFORMATION

If more than one screen,
show locations of each on sketch.