

MISSISSIPPI DEPARTMENT OF ENVIRONMENTAL QUALITY

Office of Land and Water Resources

P. O. Box 10631
Jackson, MS 39289-0631
WATER WELL DRILLERS LOG

COUNTY WELL LOCATED
PEARL RIVER

WELL NUMBER
Φ-39

CODED

DATE WELL COMPLETED
7/23/2001

PERMIT NUMBER
0-519

NAME OF DRILLING FIRM
BORGWELLSERV. PC

NAME & MAILING ADDRESS OF LANDOWNER
CARL MILLINDER

JOE STOCKSILL R. OFF

Latitude: **CARRIERS MS.**
Longitude: **39426**

WELL LOCATION. SEC TOWNSHIP RANGE
11 4 N 18 E

DISTANCE DIRECTION NEAREST TOWN
15 Miles NORTH of PEARL RIVER

OTHER LANDMARK **DOUBLE WIDE TRAILER**
JOE STOCKSILL RD.

WELL PURPOSE: Home, Irrigation, Municipal, Industrial, Fish Pond, etc.

PUMP DATA

PUMP TYPE (Circle One):
 Submersible Turbine, Flowing Well,
Other (Describe) _____

POWER TYPE (Circle One):
 Electric Tractor, Diesel, Gasoline, Butane,
Other (Describe) _____ H/P _____

DESCRIPTION OF FORMATIONS ENCOUNTERED	FROM	TO
RED CLAY	0	25
SANDY	25	40
WHITE CLAY	40	60
ROCKS	60	85
WHITE CLAY	85	105
BLUE CLAY	105	180
SAND	180	280

RECEIVED

MAY 27 2003

BY: OLWR

Top of Lap Pipe or Reduction in Casing

FEET IF TELESCOPED OR MORE THAN ONE SCREEN: USE BACK PAGE

WELL DATA

Well Depth 280	Casing Diameter (in.) 2 1/4	Casing Length (ft.) 280
Type of Casing PC	Hole Depth 280	Depth to Static Water Level 155'

TYPE OF COMPLETION: (Circle One or More):
Gravel Packed, Underreamed, Telescoped,
 Natural Development, Open Hole, Other
(Describe) **AIR**

WELL GROUTED TO A DEPTH OF **10** FEET
Type Grout (circle one): Cement, Bentonite, or Mix

SCREEN DATA

Diameter - Inches 2	Length - Feet 20'	Slot Size - Inches #10
Screen Type SLOT	Depth to Bottom - Feet 280	

I certify that the well was drilled, constructed and completed in accordance with all applicable Requirements of the Mississippi Department of Environmental Quality and/or the Mississippi Department of Health regulations and state laws.


Paul B. [Signature]
Signature of Licensed Driller and License No.

5-21-03
Date

Additional Information Required On Back

If well telescopes please sketch and show depths.

GROUND LEVEL

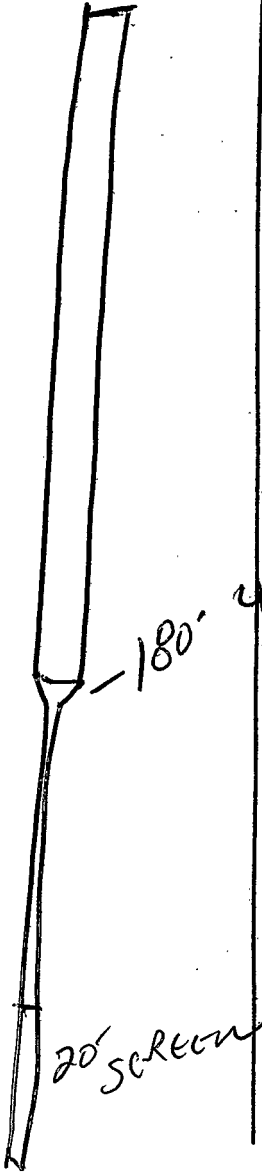

If more than one screen, show location of each on sketch.

X			

SECTION _____

Please indicate well location X.

Pump Capacity (GPM)	No. of Stages	Setting Depth	FT.
PUMP TEST			
Well yielded _____ GPM with a drawdown of _____ ft. after _____ hours of pumping			

LOG DATA

TYPE OF LOG RUN (Circle One):	No Log Run, Electric, Gamma Ray, Density, Sonic, Neutron, Other (Describe) _____
Name of Organization Running Log	

GEOLOGIC DATA (Office Use Only)

Surface Elev.	Geologic Unit	Unit Thickness	Depth to Top
Subs. SWL	Date	Analysis	Aquifer Test

Driller's Remarks
