

PEARL RIVER
 02001
 3-68

MISSISSIPPI
 BOARD OF WATER COMMISSIONERS
 416 North State Street
 Jackson, Mississippi 39201

WATER WELL DRILLERS LOG

3-12-68 19 Pentagon Well Serv Pearl River
 date well completed firm name county well located

LANDOWNER: Amel Spiers
 New No Box No.
 Rt. 1
 Carriere Miss-
 (mailing address)


description of formations encountered	from	to
Red clay	0	30
Red sand	30	90
White clay	90	118
Blue clay	118	195
Brown sand	195	225

WELL LOCATION:
 sec 24 T 4 N R 18 W
 S W
4 miles North of Cybar
 (distance) (direction) (nearest town)

WELL PURPOSE: Home
 (home, irrigation, municipal, industrial)

WELL COMPLETION DATA:

- (1) diameter (inches) 2"
- (2) total depth (feet) 225
- (3) static water level (feet) 147 below top of ground.
- (4) casing Coalv. Steel 220
 (material) (depth)
2" if telescope see back.
 (size)
- (5) screen 5 , 220
 (length) (depth to top)
2" , S. Steel
 (size) (material)
- (6) pump 2 4
 (HP) (yield gpm)
Elec
 (type power)
- (7) electric log NO
 (yes or no)
 (organization running log)
- (8) how well bottom plugged Blv. Valve

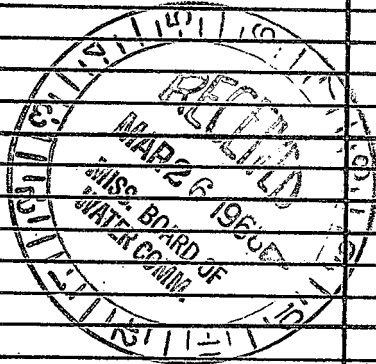

DRILLERS REMARKS:

