

Pearl River
D2002
5/18/76

MISSISSIPPI
 BOARD OF WATER COMMISSIONERS
 416 North State Street
 Jackson, Mississippi 39201

WATER WELL DRILLERS LOG

5-18- ^{13V} 26 Lemphig Well Ser. Pearl River
 date well completed firm name county well located

LANDOWNER:
Mr. Shirley Wise
Carriere, Miss.
 (mailing address)

description of formations encountered	from	to
<u>Clay</u>	<u>0</u>	<u>18</u>
<u>Sand</u>	<u>18</u>	<u>30'</u>
<u>Clay</u>	<u>30</u>	<u>50'</u>
<u>Sa. 00</u>	<u>50</u>	<u>66'</u>

WELL LOCATION:
 sec. 13 T-4 N R-18 E
9 miles West of McNeil
 (distance) (direction) (nearest town)

WELL PURPOSE: Home
 (home, irrigation, municipal, industrial)

- WELL COMPLETION DATA:
- (1) diameter (inches) 2"
 - (2) total depth (feet) 66'
 - (3) static water level (feet) 33' below above top of ground.
 - (4) casing P.V.C. 60'
 (material) (depth)
2" if telescope see back.
 (size)
 - (5) screen 6' 60'
 (length) (depth to top)
2" P.V.C.
 (size) (material)
 - (6) pump No Pumps
 (HP) (yield gpm)
 (type power)
 - (7) electric log No
 (yes or no)
 (organization running log)
 - (8) how well bottom plugged Sand Slush


RECEIVED
 OCT 26 1976

DRILLERS REMARKS:

MISS. BD. OF WATER COMMISSIONERS

If well telescopes please sketch and show depths.

GROUND LEVEL

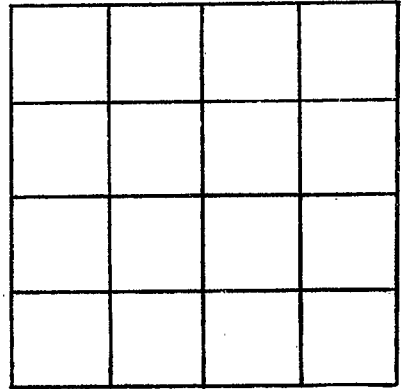

SECTION _____

Please indicate well location X.

ADDITIONAL INFORMATION

If more than one screen, show locations of each on sketch.