

Pearl River
 2003
 11-23-76

MISSISSIPPI
 BOARD OF WATER COMMISSIONERS
 416 North State Street
 Jackson, Mississippi 39201

WATER WELL DRILLERS LOG

11-23-1976 Sumplin Well Service Pearl River
 date well completed 11-23. firm name county well located


LANDOWNER:	description of formations encountered	from	to
<u>John Stewart, Jr.</u> <u>Poplarville, Ms. 39476</u> (mailing address)			
	<u>Sand</u>	<u>25</u>	<u>38</u>
	<u>Clay</u>	<u>38</u>	<u>205</u>
	<u>Sand</u>	<u>205</u>	<u>250</u>
WELL LOCATION: sec. <u>28</u> T. <u>4</u> N. R. <u>18</u> E (S) (W) <u>11</u> miles <u>W</u> of <u>McNeill</u> (distance) (direction) (nearest town)			
WELL PURPOSE: <u>home</u> (home, irrigation, municipal, industrial)			
WELL COMPLETION DATA:			
(1) diameter (inches) <u>2"</u>			
(2) total depth (feet) <u>250'</u>			
(3) static water level (feet) <u>75</u> ^{below} above top of ground.			
(4) casing <u>P.V.C. 244'</u> (material) (depth)			
<u>2"</u> if telescope see back. (size)			
(5) screen <u>6'</u> <u>244'</u> (length) (depth to top)			
<u>2"</u> <u>P.V.C.</u> (size) (material)			
(6) pump <u>Supplied own</u> (HP) (yield gpm) <u>Electric</u> (type power)			
(7) electric log <u>NO-</u> (yes or no)			
(organization running log)			
(8) how well bottom plugged <u>Sand</u> <u>Shut</u>			
DRILLERS REMARKS:			

RECEIVED
 JAN 24 1977

MISS. BD. OF WATER CONTROL

If well telescopes please sketch and show depths.

GROUND LEVEL

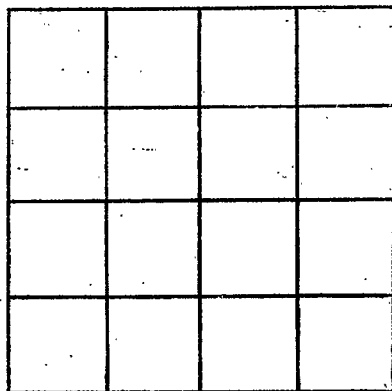

SECTION _____

Please indicate well location X.

ADDITIONAL INFORMATION

If more than one screen,
show locations of each on sketch.