

Pearl River
 2005
 10-4-76

MISSISSIPPI
 BOARD OF WATER COMMISSIONERS
 416 North State Street
 Jackson, Mississippi 39201

WATER WELL DRILLERS LOG

10-4-76 13V 76 Bird Penton & Son Pearl River
 date well completed firm name county well located

LANDOWNER:
 James L. Perry
 Rt. 1, Carriere, Ms
 (mailing address)

description of formations encountered	from	to
Red Shale	0	22
Red Sand	22	87
Blue shale	87	205
Blue Sand	205	257

WELL LOCATION:
 sec. 12 T 4 N R 18 E
 8 miles NW of Carriere
 (distance) (direction) (nearest town)

WELL PURPOSE: Home
 (home, irrigation, municipal, industrial)

WELL COMPLETION DATA:

- (1) diameter (inches) 2 in
- (2) total depth (feet) 257
- (3) static water level (feet) 130 below top of ground.
- (4) casing Galv. 252
 (material) (depth)
 if telescope see back.
- (5) screen 5 252
 (length) (depth to top)
12 8. Steel
 (size) (material)
- (6) pump 1 1/2 390 per hr.
 (HP) (yield gpm)
electric
 (type power)
- (7) electric log NO
 (yes or no)
- (organization running log)
- (8) how well bottom plugged
Sand Shale


DRILLERS REMARKS:

RECEIVED
 JAN 10 1977

Miss. S. Bd. OF WATER COMMISSIONERS

If well telescopes please sketch and show depths.

GROUND LEVEL

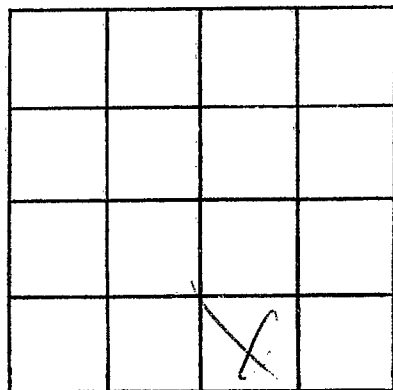

SECTION _____

Please indicate well location X.

ADDITIONAL INFORMATION

If more than one screen, show locations of each on sketch.