

Pearl River
Φ 2000
6-3-77

MISSISSIPPI
 BOARD OF WATER COMMISSIONERS
 416 North State Street
 13V Jackson, Mississippi 39201

WATER WELL DRILLERS LOG

6-3- 1977 Stocksteel Bros, Pearl River
 date well completed firm name county well located

LANDOWNER:
Sue Garrell
Route 31
Carrier, Ms.
 (mailing address)

description of formations encountered	from	to
<u>Clay</u>	<u>0</u>	<u>25</u>
<u>Clay</u>	<u>25</u>	<u>70</u>
<u>Sand</u>	<u>70</u>	<u>105</u>

WELL LOCATION:
 sec. 39 T N R 18 E
4 S 18 W
2 miles West of Henderson
 (distance) (direction) (nearest town)

WELL PURPOSE: Home
 (home, irrigation, municipal, industrial)

- WELL COMPLETION DATA:
- (1) diameter (inches) 2"
 - (2) total depth (feet) 105'
 - (3) static water level (feet) 60' below above top of ground.
 - (4) casing PVC, 100'
 (material) (depth)
2" if telescope see back.
 (size)
 - (5) screen 5', 100'
 (length) (depth to top)
2", PVC
 (size) (material)
 - (6) pump 1 325 GPH.
 (HP) (yield gpm)
Electric
 (type power)
 - (7) electric log no
 (yes or no)

(organization running log)
 (8) how well bottom plugged Sand
Shark


DRILLERS REMARKS:

RECEIVED
 JUN 17 1977

MISS. BD. OF WATER COMMISSIONERS

If well telescopes please sketch and show depths.

GROUND LEVEL

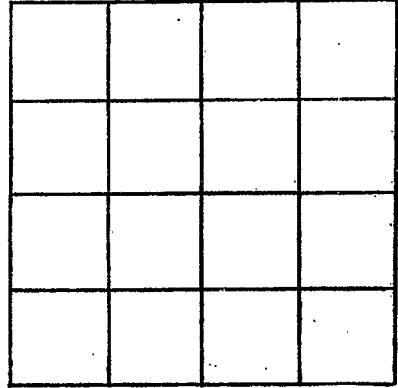

SECTION _____

Please indicate well location X.

ADDITIONAL INFORMATION

If more than one screen, show locations of each on sketch.