

Pearl River
Ø 2008
9-6-77

MISSISSIPPI
 BOARD OF WATER COMMISSIONERS
 416 North State Street
 Jackson, Mississippi 39201

13V

9-6
 date well completed

1977

STOCKSTILL BROS., INC.
 firm name

Pearl River
 county well located


LANDOWNER:	description of formations encountered	from	to
<u>Mr. D. H. Ford</u>			
<u>P.O. 1</u>	<u>Clay</u>	<u>0</u>	<u>30</u>
<u>Carriere, Miss.</u>	<u>Sand</u>	<u>30</u>	<u>100</u>
<u>Newryfield (mailing address)</u>	<u>Clay</u>	<u>100</u>	<u>190</u>
WELL LOCATION:	<u>Sand</u>	<u>190</u>	<u>230</u>
sec. <u>39</u> T <u>4</u> N S R <u>18</u> E W	<u>Clay</u>	<u>230</u>	<u>280</u>
<u>9</u> miles <u>W</u> of <u>McNeil</u>	<u>Sand</u>	<u>280</u>	<u>335</u>
(distance) (direction) (nearest town)			
WELL PURPOSE: <u>Home</u>			
(home, irrigation, municipal, industrial)			
WELL COMPLETION DATA:			
(1) diameter (inches) <u>4"</u>			
(2) total depth (feet) <u>335'</u>			
(3) static water level (feet) <u>180'</u> below top of ground.			
(4) casing <u>P.V.C.</u> , <u>325'</u>			
(material) (depth)			
<u>4"</u>			
(size) if telescope see back.			
(5) screen <u>10'</u> , <u>325'</u>			
(length) (depth to top)			
<u>4"</u> , <u>P.V.C.</u>			
(size) (material)			
(6) pump <u>1 1/2</u> , <u>19</u>			
(HP) (yield gpm)			
<u>Elec.</u>			
(type power)			
(7) electric log <u>No</u>			
(yes or no)			
<u>No</u>			
(organization running log)			
(8) how well bottom plugged <u>Sand/Silt</u>			
DRILLERS REMARKS:			

RECEIVED
 SEP 22 1977

MISS. BD. OF WATER COMMISSIONERS

If well telescopes please
sketch and show depths.

GROUND LEVEL

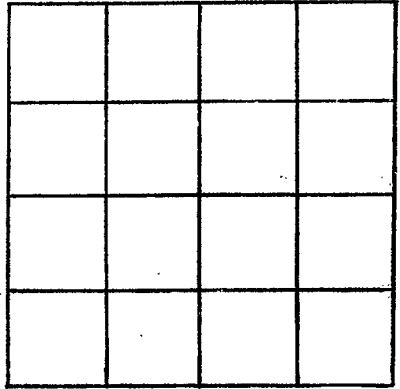

SECTION _____

Please indicate well location X.

ADDITIONAL INFORMATION

If more than one screen,
show locations of each on sketch.