

Pearl R.
 0 2009
 8/22/77

MISSISSIPPI
 BOARD OF WATER COMMISSIONERS
 416 North State Street
 Jackson, Mississippi 39201

WATER WELL DRILLERS LOG

8-22 1977 Bud Benton Pearl River
 date well completed firm name county well located

LANDOWNER:
Salvador Segato
Carini, Mrs
 (mailing address)

description of formations encountered	from	to
<u>Red shale</u>	<u>0</u>	<u>12</u>
<u>Red sand</u>	<u>12</u>	<u>63</u>

WELL LOCATION:
 sec 24 T 7 N R 18
6 miles W of Carini
 (distance) (direction) (nearest town)

WELL PURPOSE: Home
 (home, irrigation, municipal, industrial)

- WELL COMPLETION DATA:
- (1) diameter (inches) 4 in
 - (2) total depth (feet) 63
 - (3) static water level (feet) 40 ^{below} top of ground.
 - (4) casing PVC, 53,
 (material) (depth)
 - (size) If telescope see back.
 - (5) screen 4x10, 53
 (length) (depth to top)
12, PVC
 (size) (material)
 - (6) pump 1/2, 600
 (HP) (yield gpm)
electric, 109 gpm
 (type power)
 - (7) electric log NO
 (yes or no)


(organization running log)
 (8) how well bottom plugged Red Shale

DRILLERS REMARKS:

RECEIVED
 DEC 30 1977

If well telescopes please sketch and show depths.

GROUND LEVEL

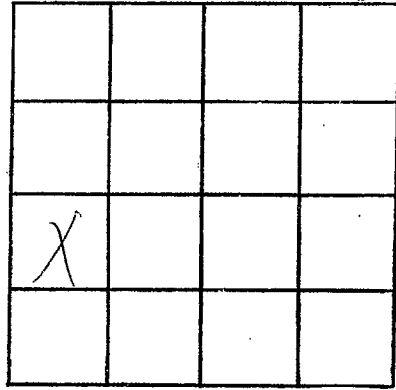

SECTION _____

Please indicate well location X.

ADDITIONAL INFORMATION

If more than one screen,
show locations of each on sketch.