

Pearl R.  
 2010  
 9/29/77

MISSISSIPPI  
 BOARD OF WATER COMMISSIONERS  
 416 North State Street  
 Jackson, Mississippi 39201

WATER WELL DRILLERS LOG

9-29-77 Bud Penton Pearl River  
 date well completed firm name county well located

LANDOWNER:  
 Elbert Mitchell  
 Cammie, Mrs.  
 (mailing address)

description of formations encountered	from	to
Red Shale	0	22
Red Sand	22	82

WELL LOCATION:  
 sec 24 T 4 N R 18 E  
 6 miles W of Cammie  
 (distance) (direction) (nearest town)

WELL PURPOSE: Home  
 (home, irrigation, municipal, industrial)

- WELL COMPLETION DATA:
- (1) diameter (inches) 4 in
  - (2) total depth (feet) 82
  - (3) static water level (feet) 35 below top of ground.
  - (4) casing PVC 72 (material) (depth)
  - (size) If telescope see back.
  - (5) screen 4x10 72 (length) (depth to top)
  - 12 PVC (size) (material)
  - (6) pump 1/2 1200 1200 gpm (HP) (yield gpm)
  - electric (type power)
  - (7) electric log NO (yes or no)

(organization running log)

(8) how well bottom plugged Sand Shale


DRILLERS REMARKS:

RECEIVED  
 DEC 30 1977

MISS. BD. OF WATER COMMISSIONERS

If well telescopes please sketch and show depths.

GROUND LEVEL

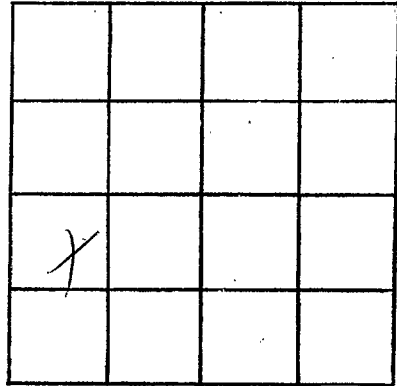

SECTION \_\_\_\_\_

Please indicate well location X.

ADDITIONAL INFORMATION

A series of horizontal lines for writing additional information, starting below the 'ADDITIONAL INFORMATION' header and extending down to the bottom of the page.

If more than one screen, show locations of each on sketch.