

Pearl River
Φ 2011
9-21-77

MISSISSIPPI
 BOARD OF WATER COMMISSIONERS
 416 North State Street
 Jackson, Mississippi 39201

RECEIVED

13V

WATER WELL DRILLERS LOG - 5 1977

MOORE SERVICE CO.
 WATER COMPANY

Sept 21 1977 date well completed
 MID-SOUTH DRILLING firm name
 MISS. CO. county well located

LANDOWNER: DARRELL
M & Lemone Mt. Brg 240
Crossier, Miss
 (mailing address)

WELL LOCATION:
 sec. 20 T. 4 S. R. 18 W.
14 miles NW of Prepton
 (distance) (direction) (nearest town)

WELL PURPOSE: HOME
 (home, irrigation, municipal, industrial)


- WELL COMPLETION DATA:
- (1) diameter (inches) 4"
 - (2) total depth (feet) 84
 - (3) static water level (feet) 52 below above top of ground.
 - (4) casing Std 74
 (material) (depth)
 - (size) if telescope see back.
 - (5) screen 10x4" 74 ft.
 (length) (depth to top)
 - 4
 (size) (material)
 - (6) pump 1238 10
 (HP) (yield gpm)
 - 230 AC
 (type power)
 - (7) electric log NO
 (yes or no)
 - SEA
 (organization) running log
 - (8) how well bottom plugged 2955

description of formations encountered	from	to
<u>Red Plug</u>	<u>0</u>	<u>18</u>
<u>fine sand brown</u>	<u>18</u>	<u>25</u>
<u>purple clay</u>	<u>25</u>	<u>30</u>
<u>white sand</u>	<u>30</u>	<u>37</u>
<u>purple clay</u>	<u>37</u>	<u>60</u>
<u>sm. broken s</u>		
<u>fine sand</u>	<u>60</u>	<u>84</u>
<u>white clay</u>	<u>84</u>	
<u>Set end 84 ft</u>		

DRILLERS REMARKS:

If well telescopes please sketch and show depths.

GROUND LEVEL

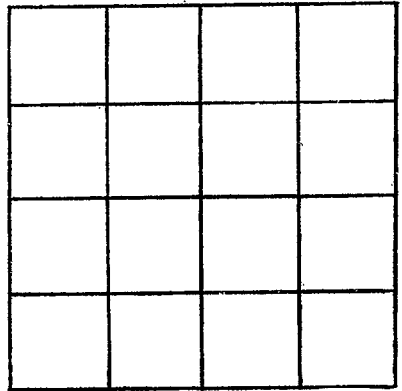

SECTION _____

Please indicate well location X.

ADDITIONAL INFORMATION

If more than one screen, show locations of each on sketch.