

Pearl R.
 10-3-77

MISSISSIPPI
 BOARD OF WATER COMMISSIONERS
 416 North State Street
 Jackson, Mississippi 39201

WATER WELL DRILLERS LOG

10-3-77 date well completed Bud Benton firm name Pearl River county well located

LANDOWNER:
 Bill Wagner
 Carriere, Miss
 (mailing address)

description of formations encountered	from	to
Red shale	0	22
Red sand	22	82

WELL LOCATION:
 sec. 24 T. 4 N. R. 18 E.
 6 miles W of Carriere
 (distance) (direction) (nearest town)

WELL PURPOSE: Home
 (home, irrigation, municipal, industrial)

WELL COMPLETION DATA:

(1) diameter (inches) 4 in

(2) total depth (feet) 82

(3) static water level (feet) 35 below top of ground.

(4) casing PVC 72 (material) (depth)

(size) if telescope see back.

(5) screen 4x0 72 (length) (depth to top)

12 PVC (size) (material)

(6) pump 1/2 800 (HP) (yield gpm)

electric (type power)

(7) electric log NO 139ppm (yes or no)

(organization running log)

(8) how well bottom plugged Sand Shale


RECEIVED
 DEC 30 1977

DRILLERS REMARKS:

MISS. BD. OF WATER COMMISSIONERS

If well telescopes please sketch and show depths.

GROUND LEVEL

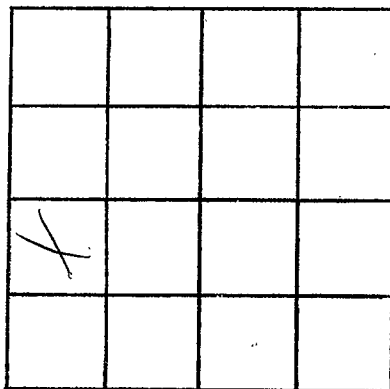

SECTION _____

Please indicate well location X.

ADDITIONAL INFORMATION

If more than one screen,
show locations of each on sketch.