

Pearl R.  
 2013  
 10/3/77

MISSISSIPPI  
 BOARD OF WATER COMMISSIONERS  
 416 North State Street  
 Jackson, Mississippi 39201

WATER WELL DRILLERS LOG

10-3 1977 Bud Benton Pearl River  
 date well completed firm name county well located

LANDOWNER: Burke  
 Jimmy Burke  
 Carriere, Ms.  
 (mailing address)

description of formations encountered  
 Red Shale  
 Red Sand  
 from 9 to 18  
 18 72

WELL LOCATION:  
 sec. 24 T. 4 N. R. 18 E.  
 8 miles W of Carriere  
 (distance) (direction) (nearest town)

WELL PURPOSE: Home  
 (home, irrigation, municipal, industrial)

WELL COMPLETION DATA:  
 (1) diameter (inches) 4 in  
 (2) total depth (feet) 72  
 (3) static water level (feet) 30 <sup>below</sup> above top of ground.  
 (4) casing PVC, 62, (material) (depth)  
 (size) If telescope see back.  
 (5) screen 4x10, 62 (length) (depth to top)  
 12, PVC (size) (material)  
 (6) pump 1/2, 800 (HP) (yield gpm)  
 electric (type power)  
 (7) electric log NO 139pm (yes or no)

(organization running log)  
 (8) how well bottom plugged Sand Shale


DRILLERS REMARKS:

RECEIVED  
 DEC 30 1977

MISS. DD. OF WATER COMMISSIONERS

If well telescopes please sketch and show depths.

GROUND LEVEL

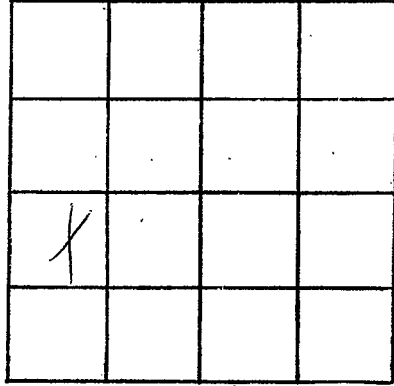

SECTION \_\_\_\_\_

Please indicate well location X.

ADDITIONAL INFORMATION

If more than one screen, show locations of each on sketch.