

PEARL RIVER

0 2016

12-20-78

MISSISSIPPI BOARD OF WATER COMMISSIONERS 416 North State Street Jackson, Mississippi 39201

WATER WELL DRILLERS LOG

12/20 date well completed

1978 Bud Perkinson firm name

Pearl River county well located

LANDOWNER: SJ LIANG

RT. 1 Box 143E Carrier Miss (mailing address)

description of formations encountered

Red shale Red sand

from 0 to 21 70

WELL LOCATION:

sec. 26 T 4 N R 18 E 9 miles W of Carrier (distance) (direction) (nearest town)

WELL PURPOSE: home (home, irrigation, municipal, industrial)

WELL COMPLETION DATA:

- (1) diameter (inches) 4 1/2"
(2) total depth (feet) 70
(3) static water level (feet) 42 below top of ground
(4) casing PVC 70 (material) (depth) 30 (size) if telescope see back.
(5) screen 4x10 60 (length) (depth to top) 12 PVC (size) (material)
(6) pump 1/2 (HP) 800 (yield gpm) Elect (type power)
(7) electric log NO (yes or no)

(organization running log)

(8) how well bottom plugged Sand short

DRILLERS REMARKS:


RECEIVED stamp

JAN 26 1978

MISS. BD. OF WATER COMM

If well telescopes please sketch and show depths.

GROUND LEVEL

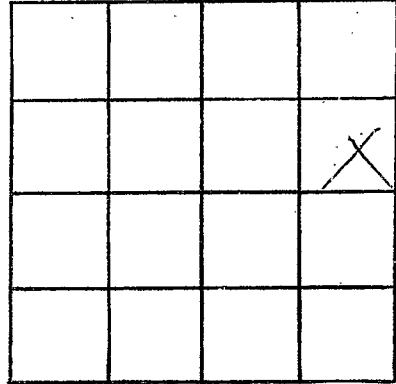

SECTION \_\_\_\_\_

Please indicate well location X.

ADDITIONAL INFORMATION

If more than one screen, show locations of each on sketch.