

PEARL RIVER

0 2017

11-06-78

MISSISSIPPI BOARD OF WATER COMMISSIONERS
416 North State Street
Jackson, Mississippi 39201

WATER WELL DRILLERS LOG

1/16 1978 date well completed

Budparton & Son firm name

Pearl River county well located

LANDOWNER: Wayne Mitchell

description of formations encountered

from

to

B.T. 1	Carrier's	Red shaly	0	35
		Red sand	35	58
		Blue shale	55	235
		Gray sand	235	265

(mailing address)

WELL LOCATION:

sec 26 T 4 N R 18 E
6 miles W of Carrier
(distance) (direction) (nearest town)

WELL PURPOSE: home
(home, irrigation, municipal, industrial)

WELL COMPLETION DATA:

- (1) diameter (inches) 4"
- (2) total depth (feet) 265
- (3) static water level (feet) 112 below top of ground
- (4) casing PVC 253' (material) (depth)
- (5) screen 4x10 253' (length) (depth to top)
- (6) pump 1 650 (HP) (yield gpm)
- (7) electric log no (yes or no)

(organization running log)

(8) how well bottom plugged Sand shaly

DRILLERS REMARKS:


RECEIVED

JAN 20 1978

MISS. BD. OF WATER COMM

If well telescopes please
sketch and show depths.

GROUND LEVEL

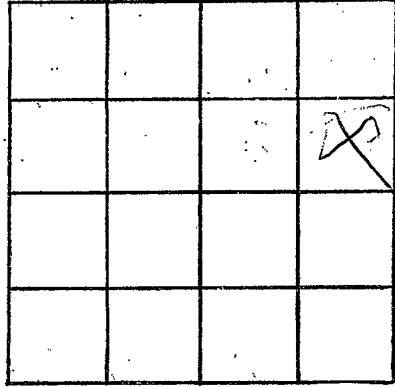

SECTION _____

Please indicate well location X.

ADDITIONAL INFORMATION

If more than one screen,
show locations of each on sketch.